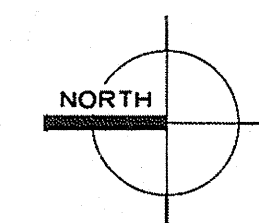


- 1 EXISTING DUST COLLECTION SYSTEM TO BE RELOCATED, INTERCEPT EXISTING CONDUIT AND EXTEND TO THE NEW LOCATION. PROVIDE NEW CONDUCTITORS FROM EXISTING STARTER, PROVIDE NEW 480V 3-POLE DISCONNECT.
- 2 PROVIDE TWO (2) WIREHOLE TWO GANG EXTRA DEAD DEVICE BOXES. PROVIDE V2000 WIREWAY DROP DOWN WALL FROM CEILING INSIDE OF PROJECT CHAMBER AND EXTENSIBLE CH4 TO FEED THROUGH TO ROOMS, CONNECT THE TWO BOXES TOGETHER WITH V2000 WIREWAY.
- 3 PROVIDE (2) NEW 30A GMB SWITCH BUCKETS AND 15A FUSES TO FEED P-3 AND P-4.

 $1/8^{\circ} \pm 7.0^{\circ}$ 