
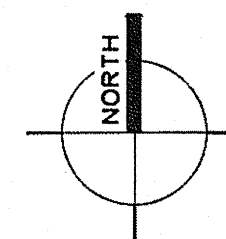


No part of this drawing may be reproduced in any form or by any means, stored in a database or retrieval system, without written permission of OMA Architects + Engineers.

015-038A15-0102-004.dwg  
PLOT DATE / TIME: 6/25/2009 6:48:07 AM

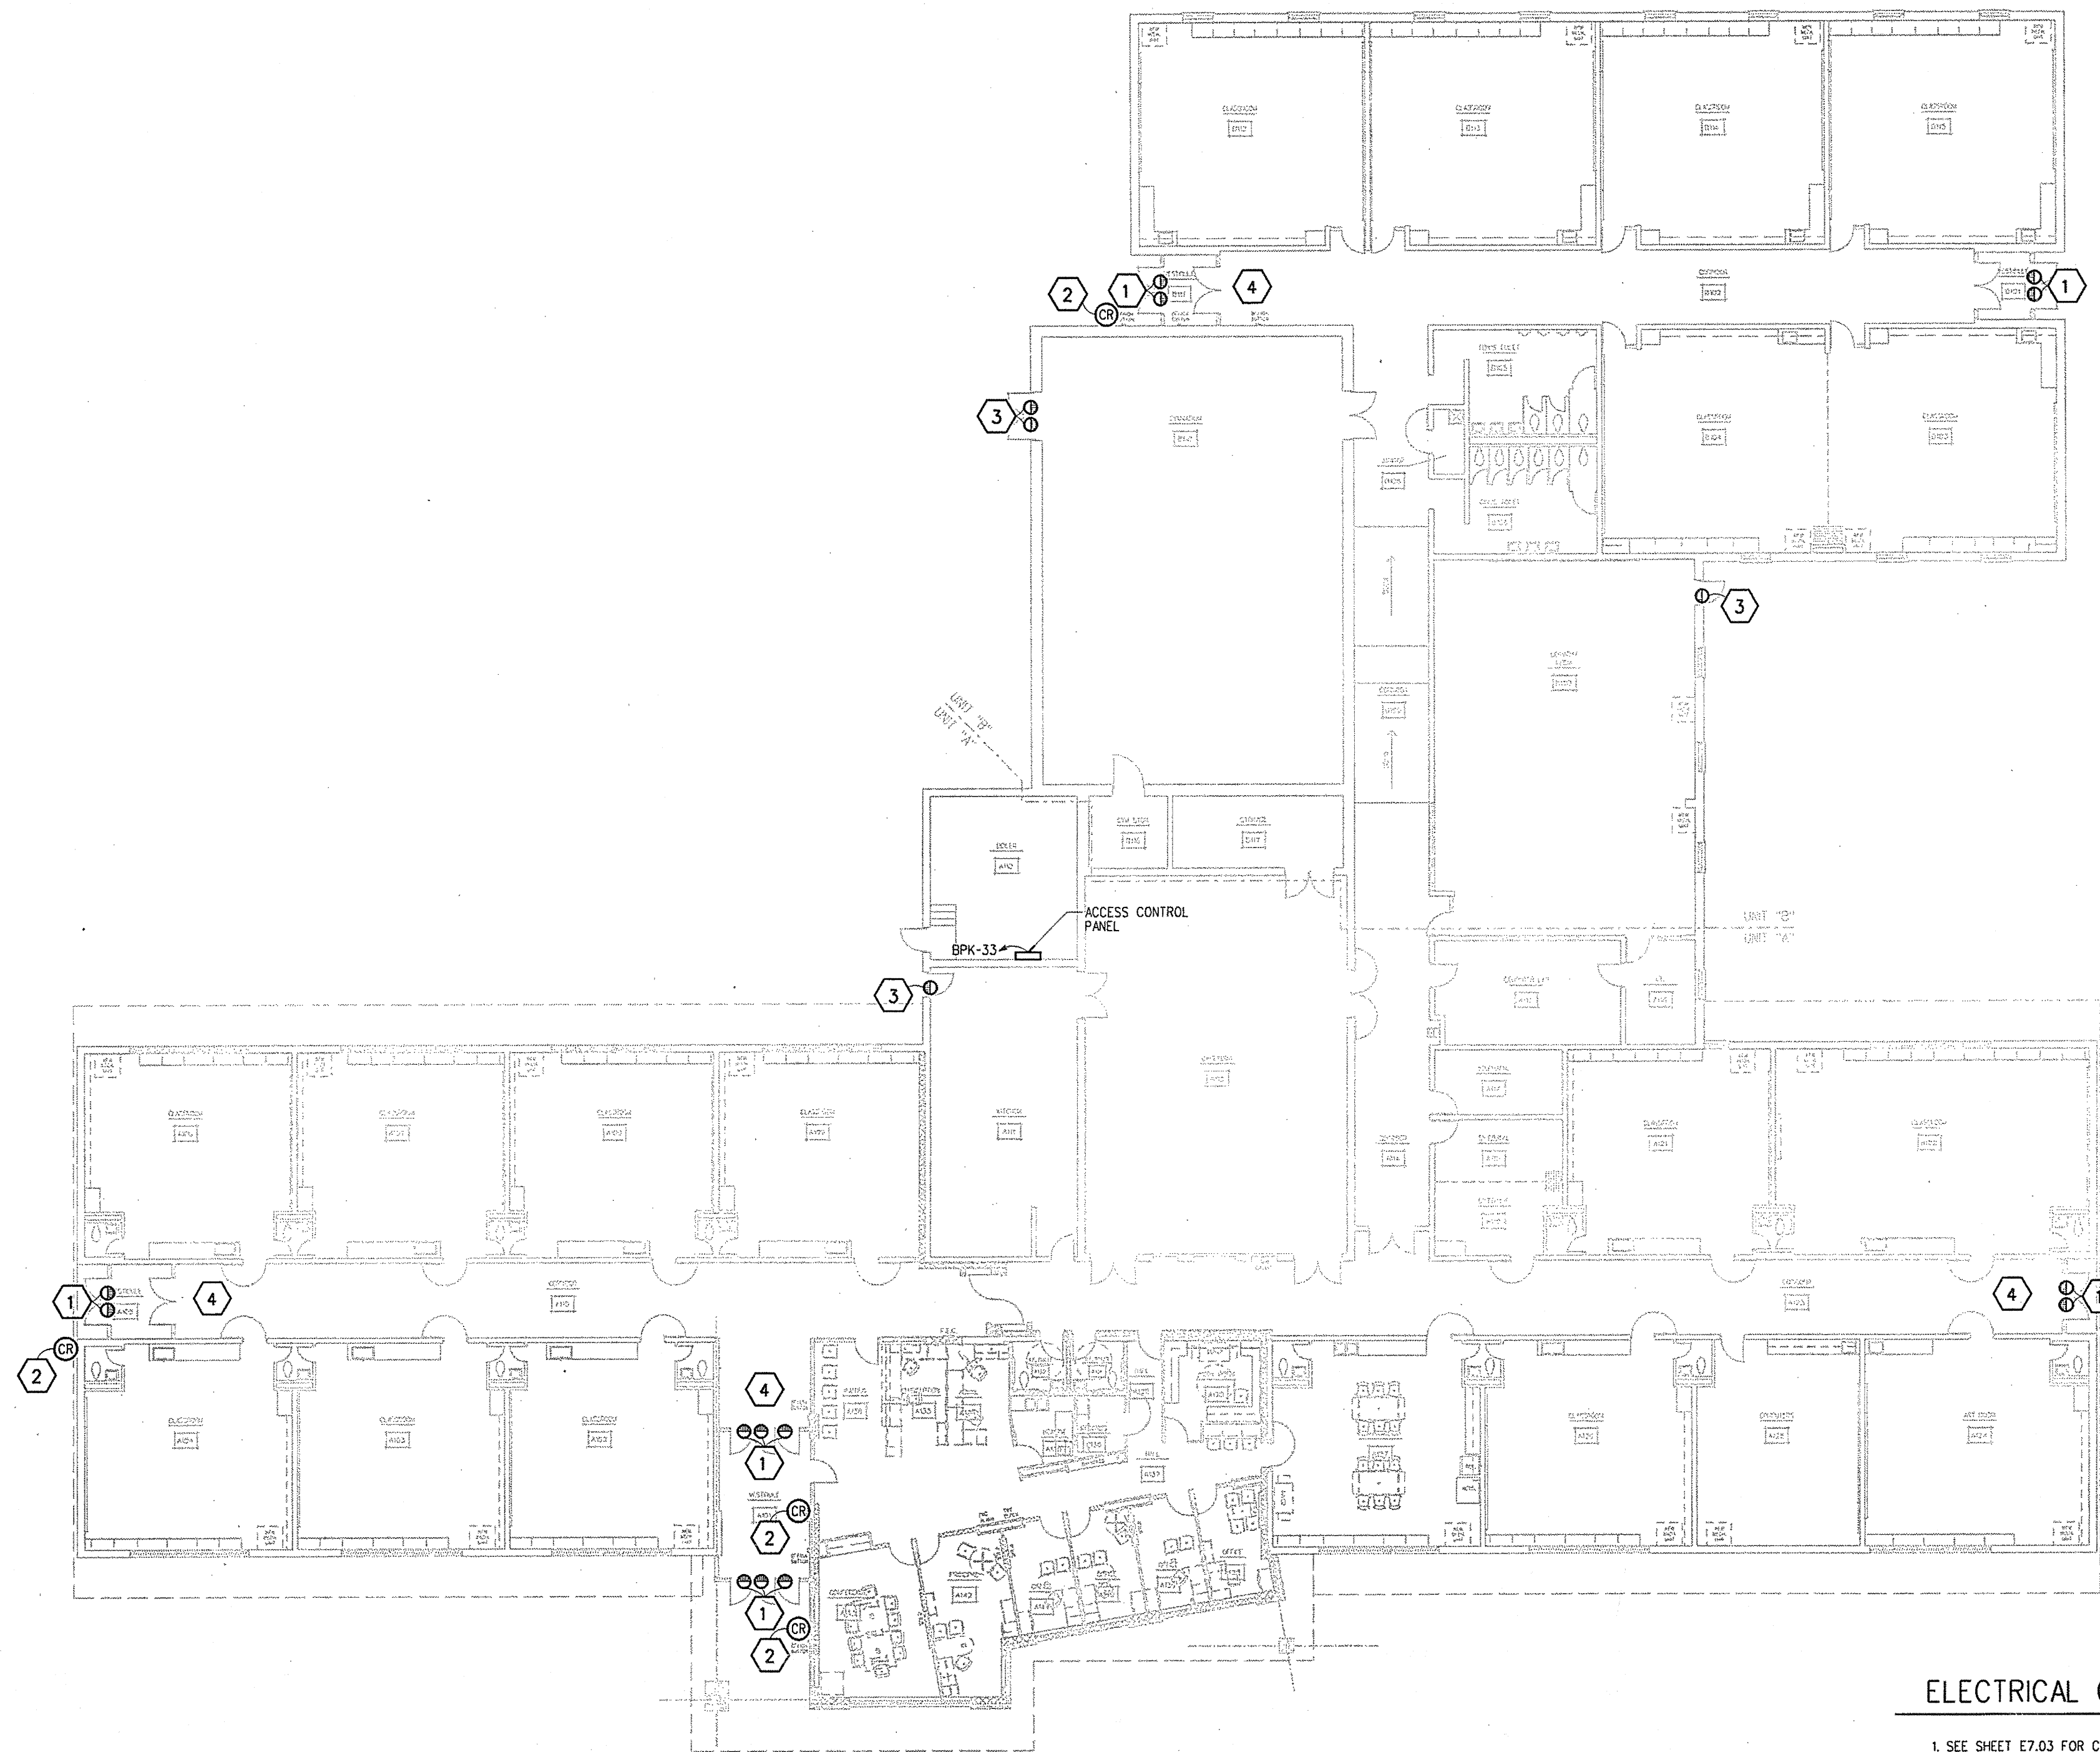

# STEEBY ELEMENTARY OVERALL ELECTRICAL PLAN


Scale: 1/8" = 1'

## ELECTRICAL GENERAL NOTES

1. SEE SHEET E7.03 FOR CARD ACCESS DETAILS.

## ELECTRICAL KEY NOTES: (THIS SHEET ONLY)

1. E.C. TO PULL LOW VOLTAGE CABLING FROM DOOR CONTROLLER AND FISH DOWN MILLION OR DOOR FRAME FOR LATCH BOLT RETRACTION WITH BOLT DETECTION. INSTALL REQUEST TO EXIT DEVICE ON CEILING IN FRONT OF DOOR. PROVIDE CABLING IN WIREMOLD INTO DOOR FRAME.
2. NEW CARD READER. E.C. TO PROVIDE LOW VOLTAGE CABLING FROM DOOR CONTROLLER.
3. PROVIDE LOW VOLTAGE CABLING FROM NEAREST DOOR CONTROLLER INTO DOOR FRAME FOR DOOR MONITORING.
4. DOOR CONTROLLER. PROVIDE 20A 120V POWER FROM EXISTING JUNCTION BOX ABOVE CEILING.

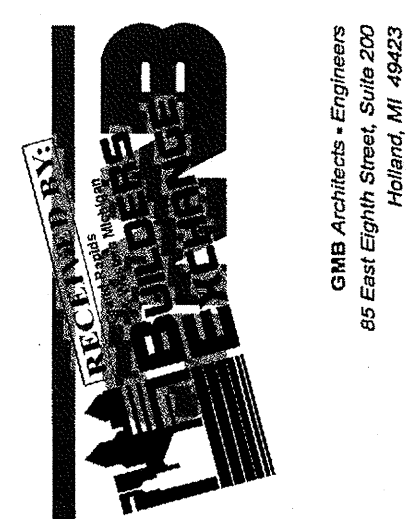

OMA Architects + Engineers  
60 East Eighth Street, Suite 200  
Ann Arbor, MI 48106  
Phone: 734.769.1234  
Fax: 734.769.1235  
www.omaarchitects.com

FINE ARTS CENTER ADDITION  
**WAYLAND UNION SCHOOLS**  
WAYLAND, MICHIGAN

PROJECT NO. 5-1282  
Copyright © 2009  
OMA Architects + Engineers  
All Rights Reserved  
STEEBY ELEMENTARY  
CARD ACCESS  
ELECTRICAL PLAN

**E2.04**