

DATES OF ISSUE		
NO.	DATE	DESCRIPTION
1	5-7-09	GC REVIEW
2	6-24-09	BIDS AND CONSTRUCTION
3		
4		
5		
6		
7		
8		
9		
10		


Copyright 2009 Acoustics By Design, Inc. All information on this drawing is the exclusive property of Acoustics By Design, Inc. and is furnished for use on the above project only. No part of this drawing may be duplicated without written consent from Acoustics By Design, Inc.

WAYLAND HIGH SCHOOL
HIGH SCHOOL ADDITIONS AND REMODELING
WAYLAND, MICHIGAN


Designed by TGH, SS	Date Drawn: 5-1-2009
Drawn by: DWB	
Checked By: TGH, SS	
Sheet Title THEATRICAL LIGHTING SECOND FLOOR LOCATIONS	

Sheet No. 13 of 14
Drawing Scale: 1/8" = 1'-0"

TL202

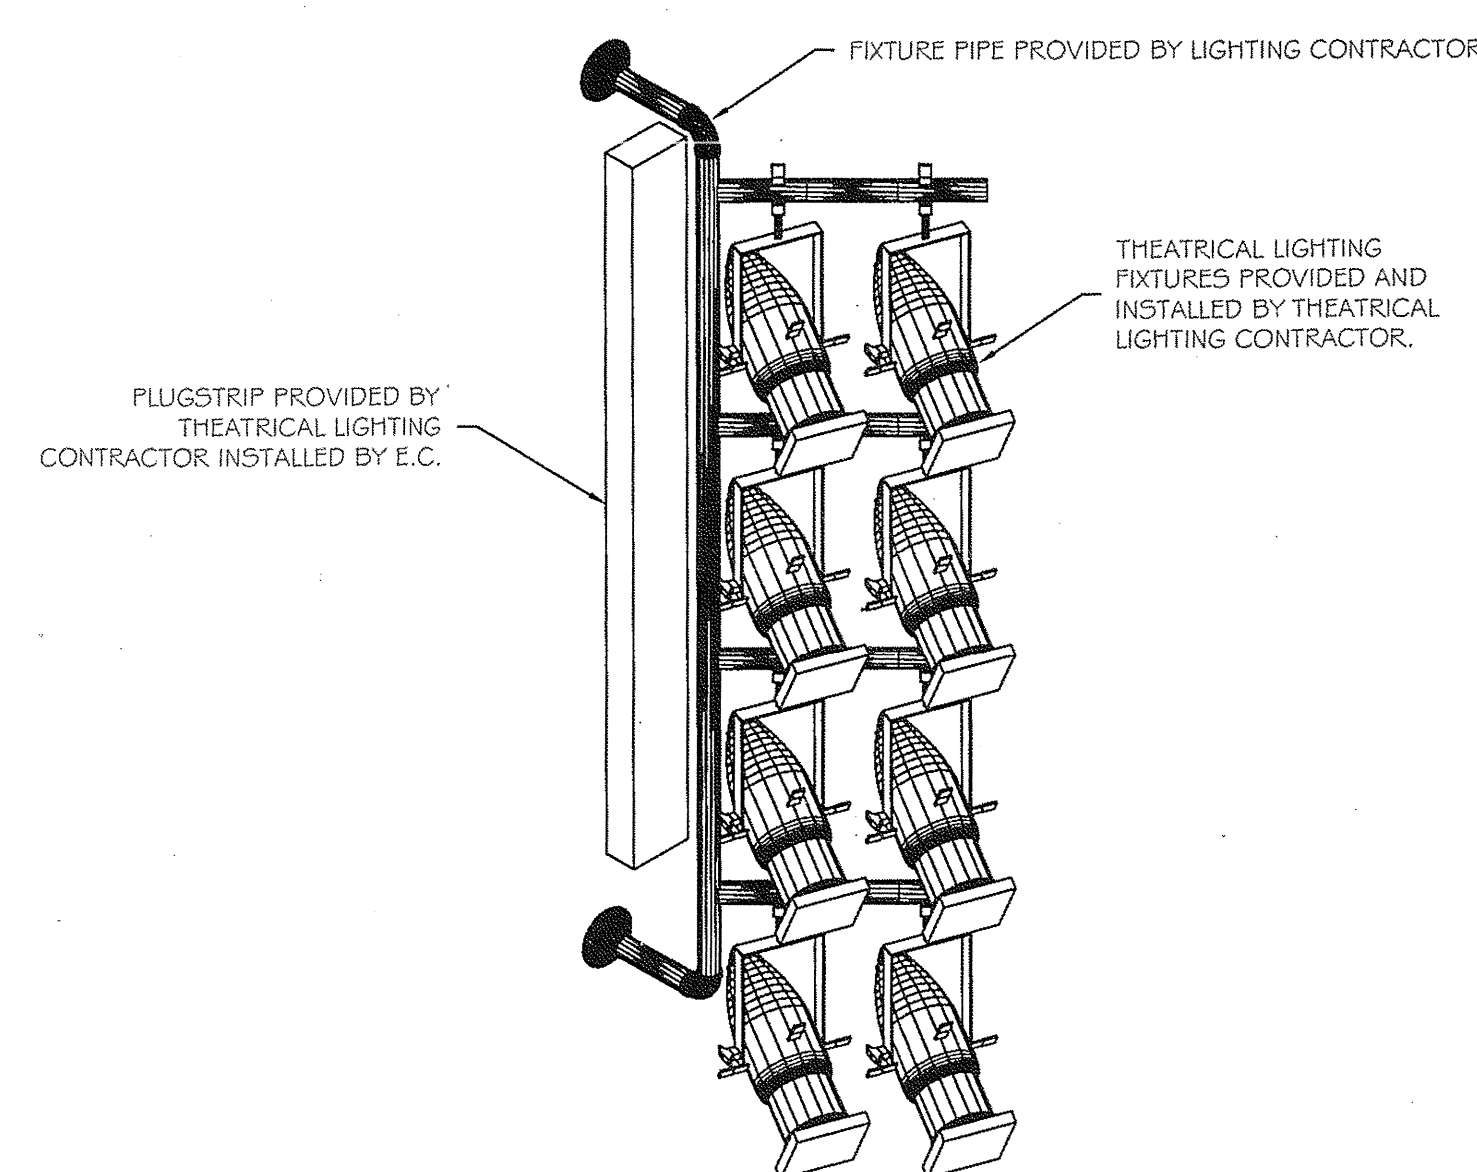

1 TECH DECK PIPE DETAIL
NO SCALE

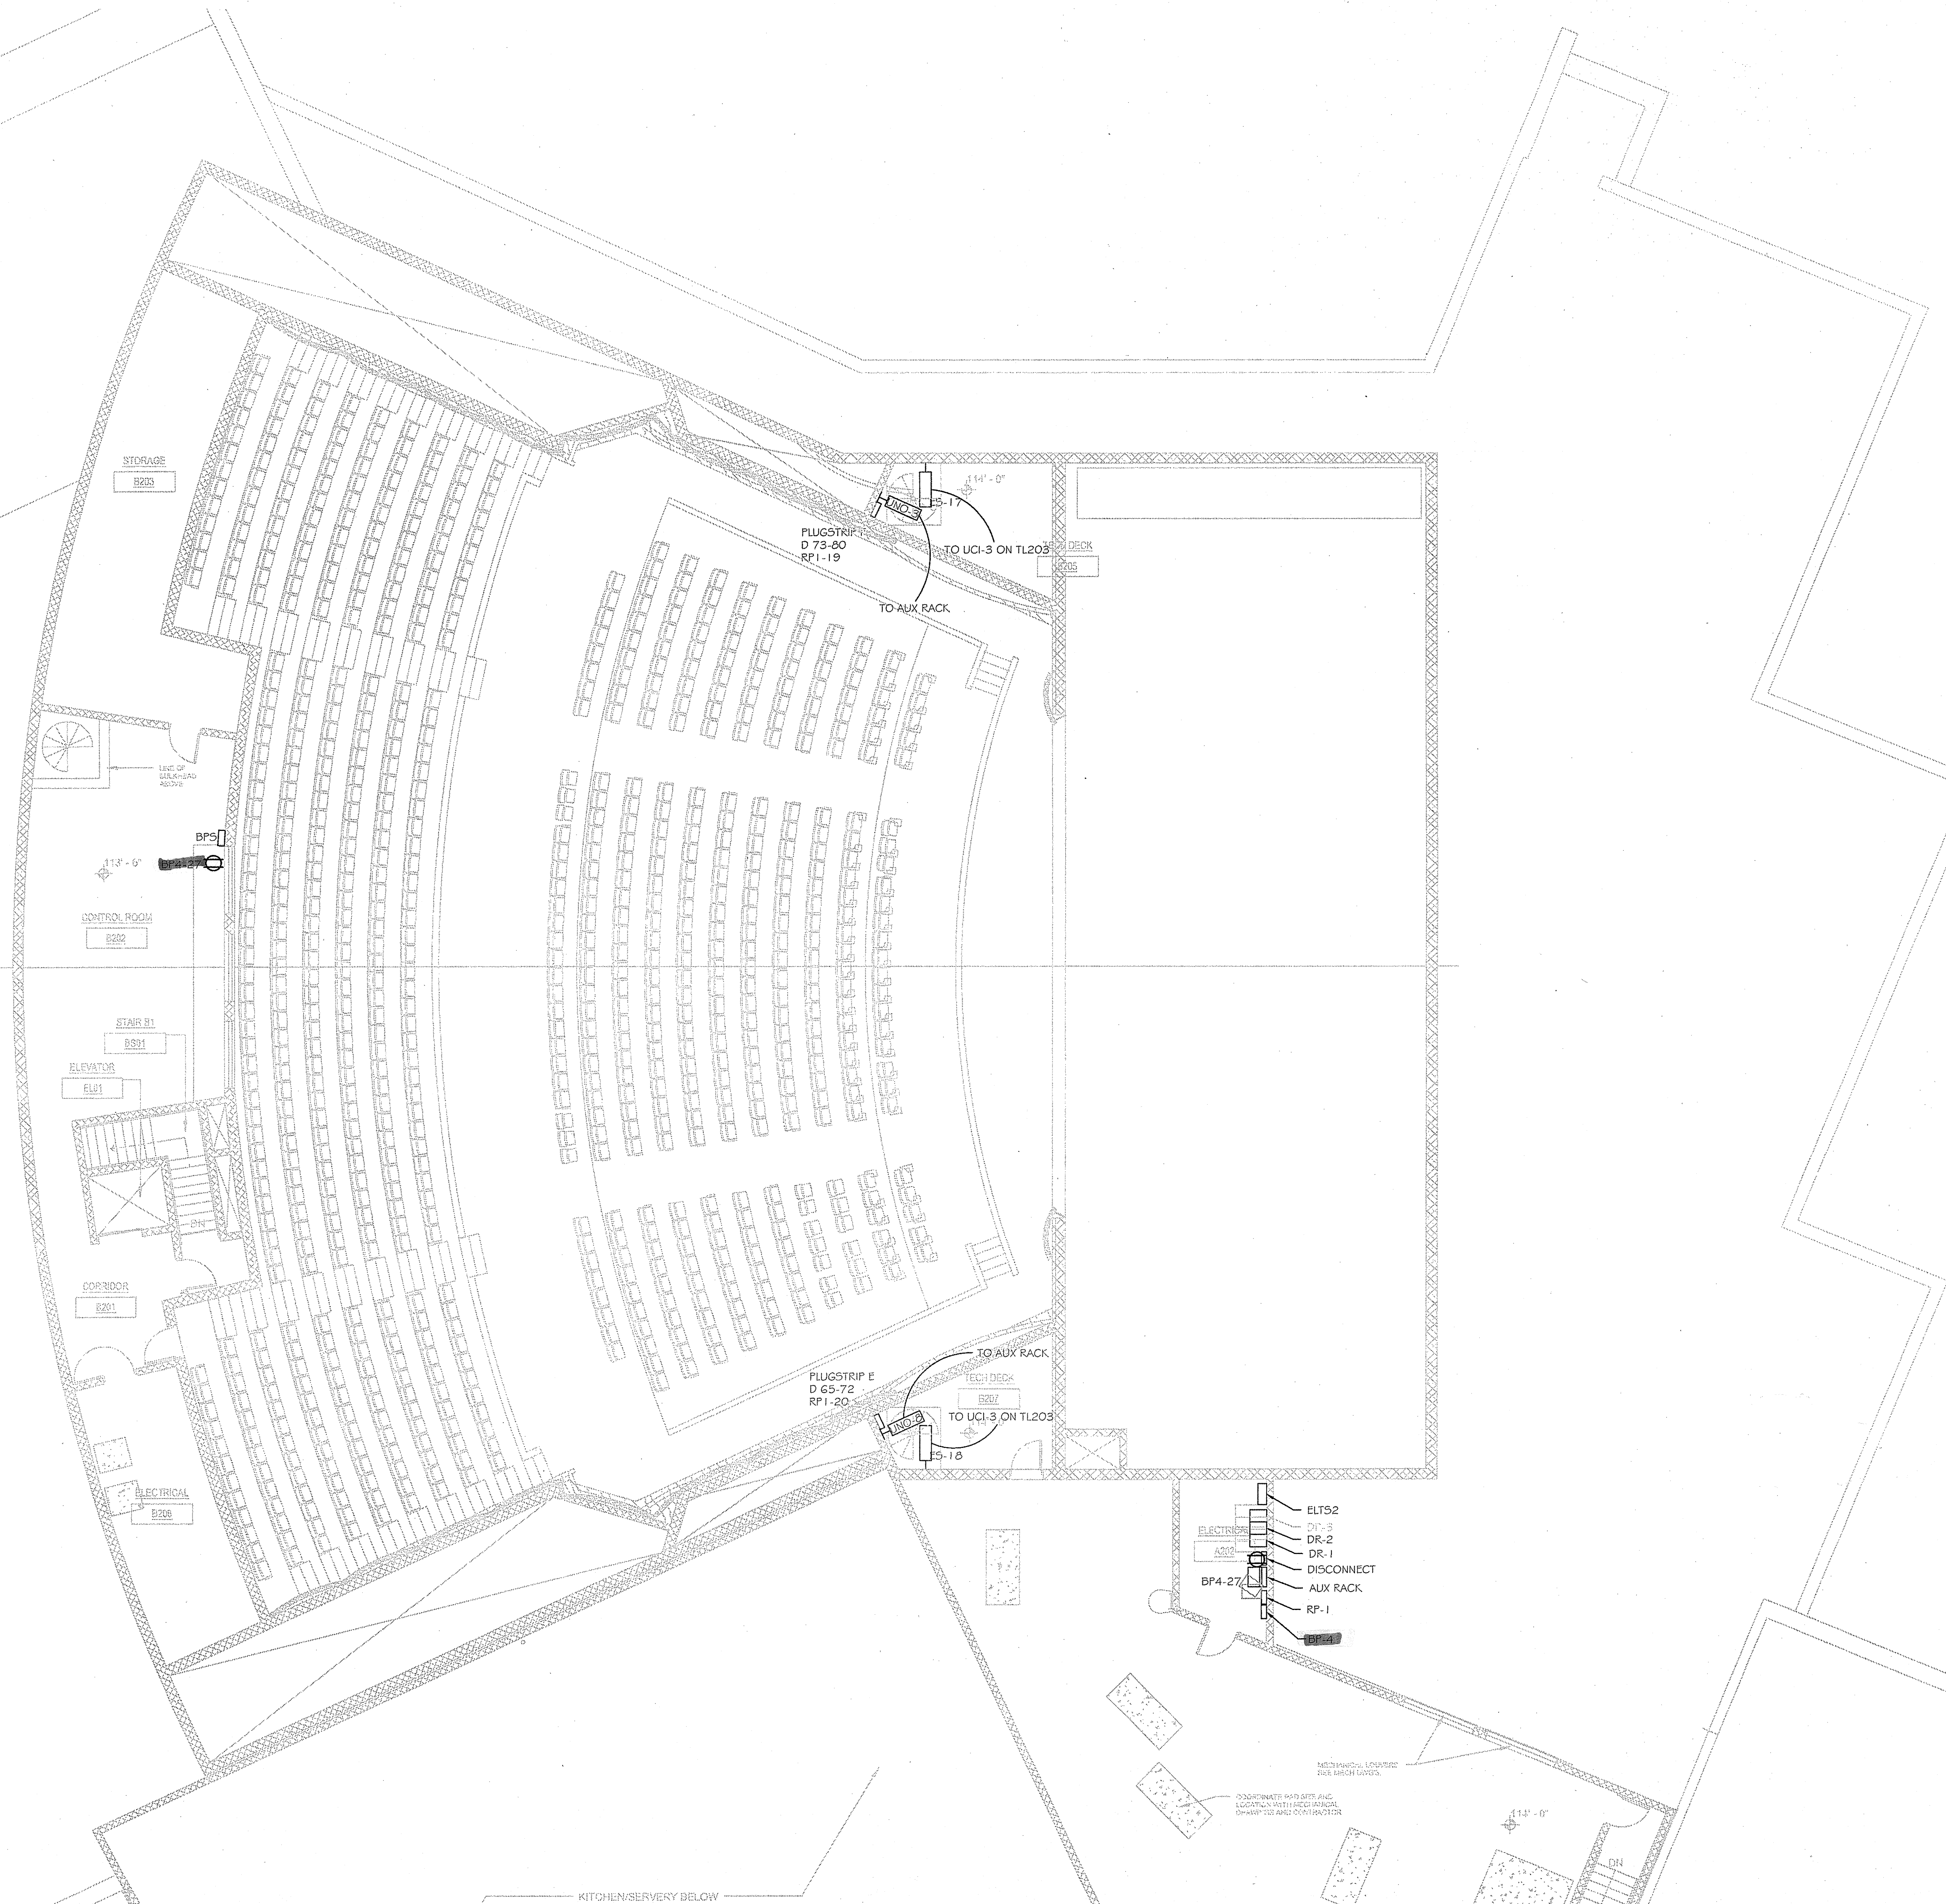

2 THEATRICAL LIGHTING CONDUIT AND BOX LOCATIONS SECOND FLOOR
SCALE: 1/8" = 1'-0"