




1 TOUCH PANEL TP-1 (MAIN)
NO SCALE

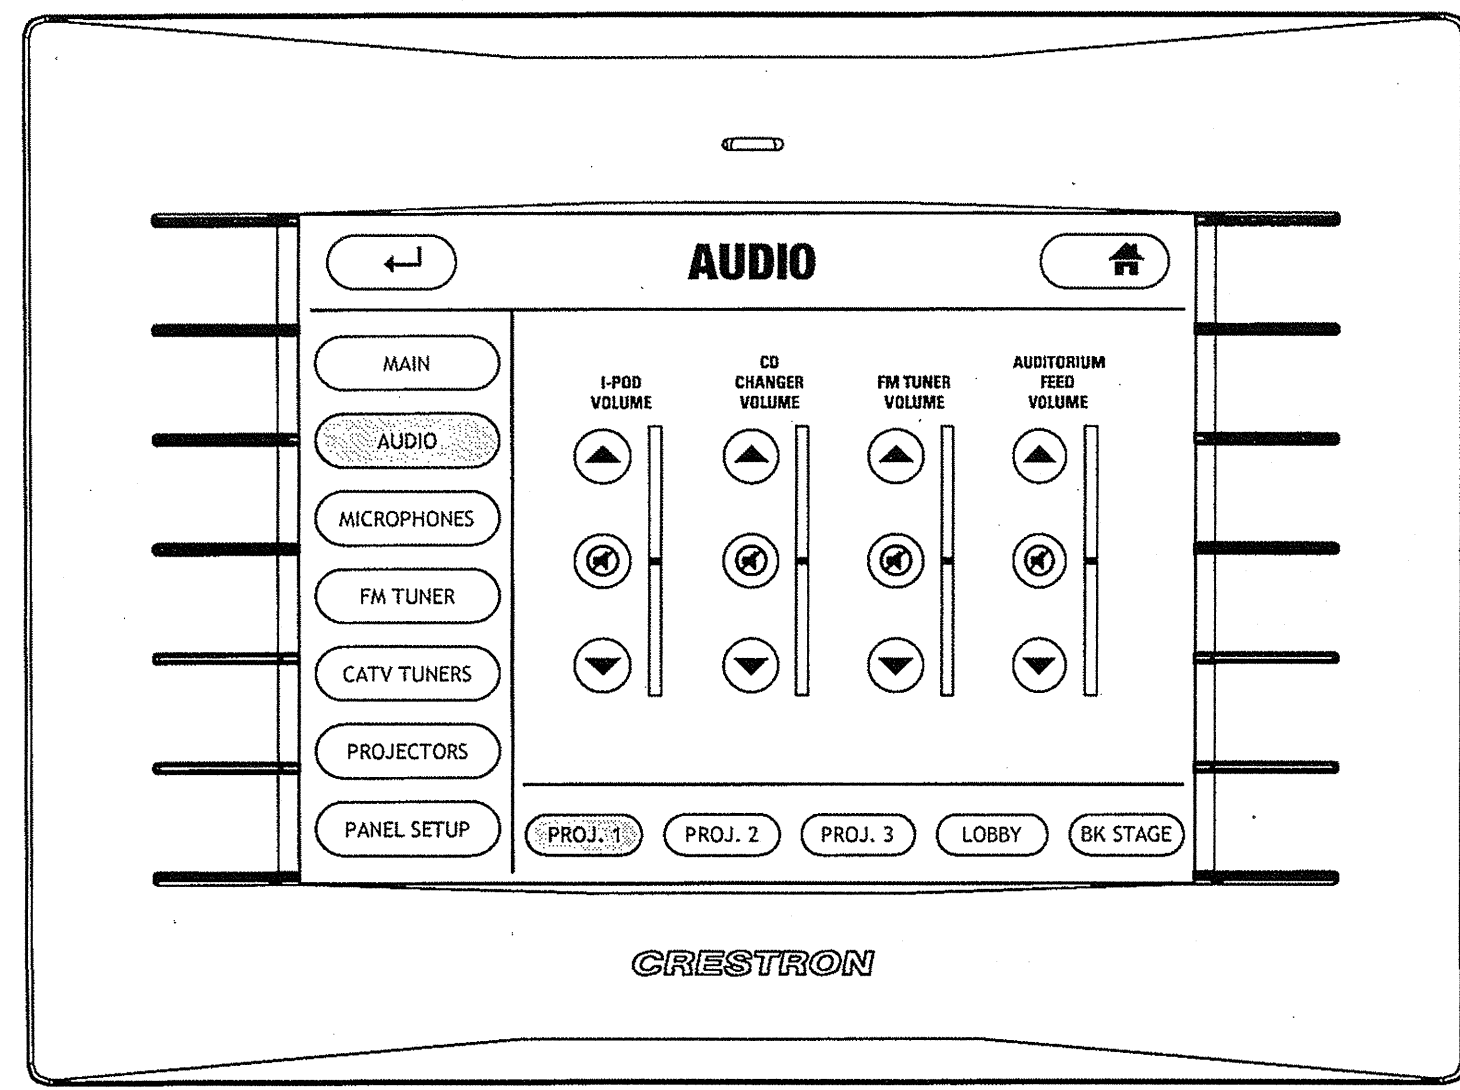


2 TOUCH PANEL TP-1 (AUDIO)
NO SCALE

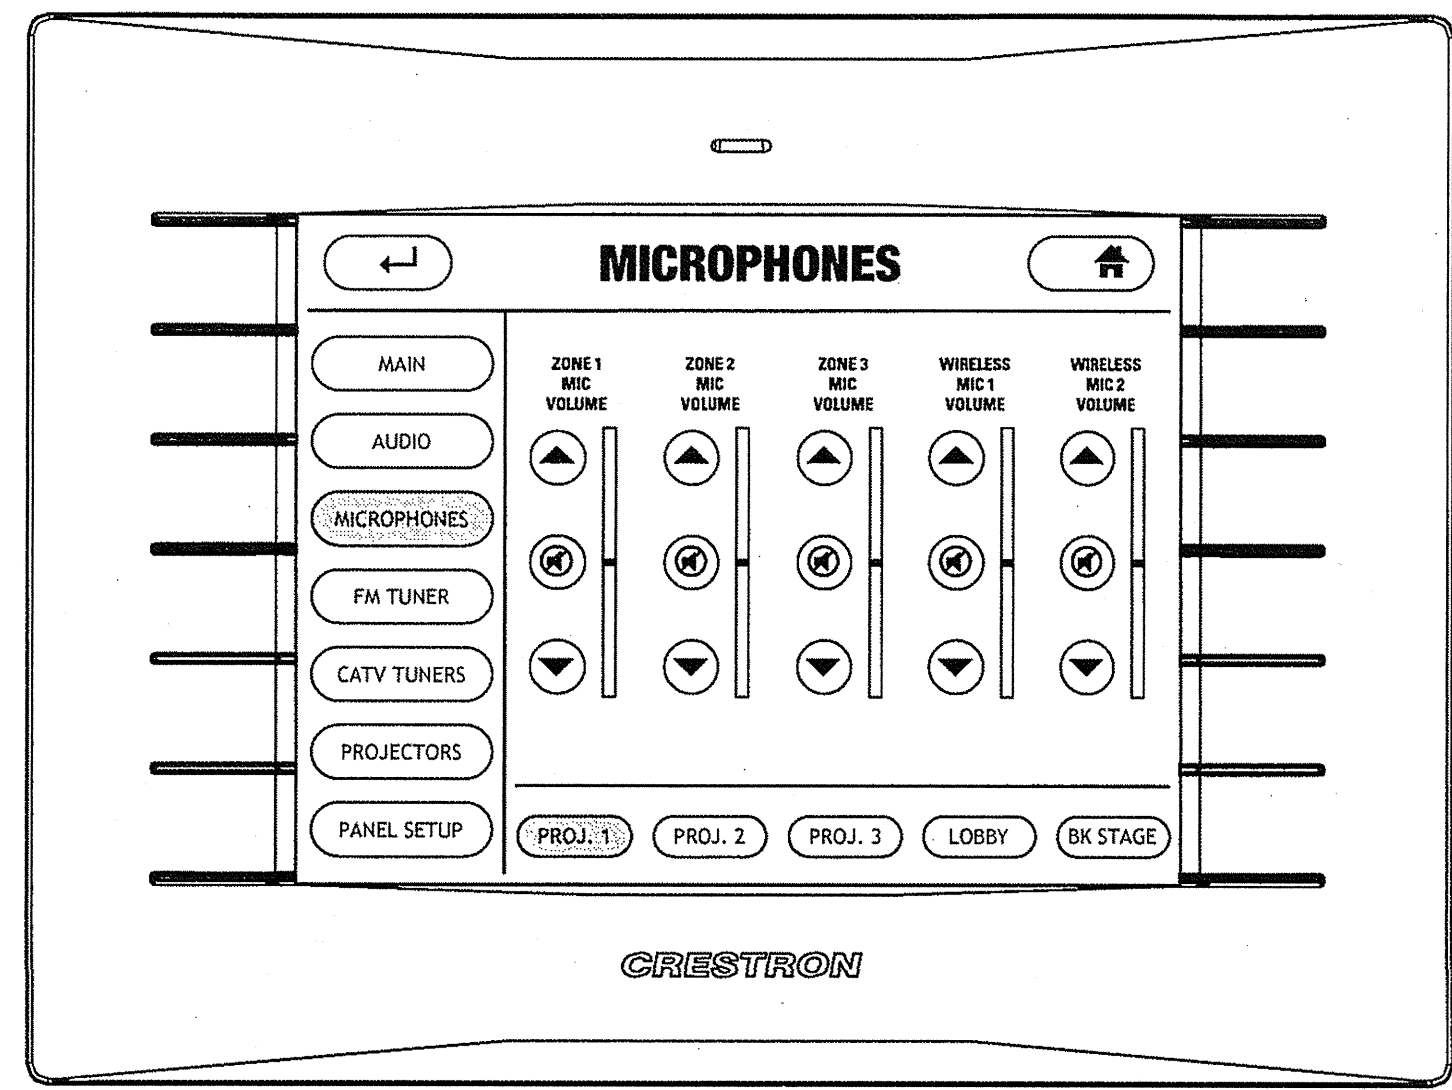


3 TOUCH PANEL TP-1 (MICROPHONES)
NO SCALE

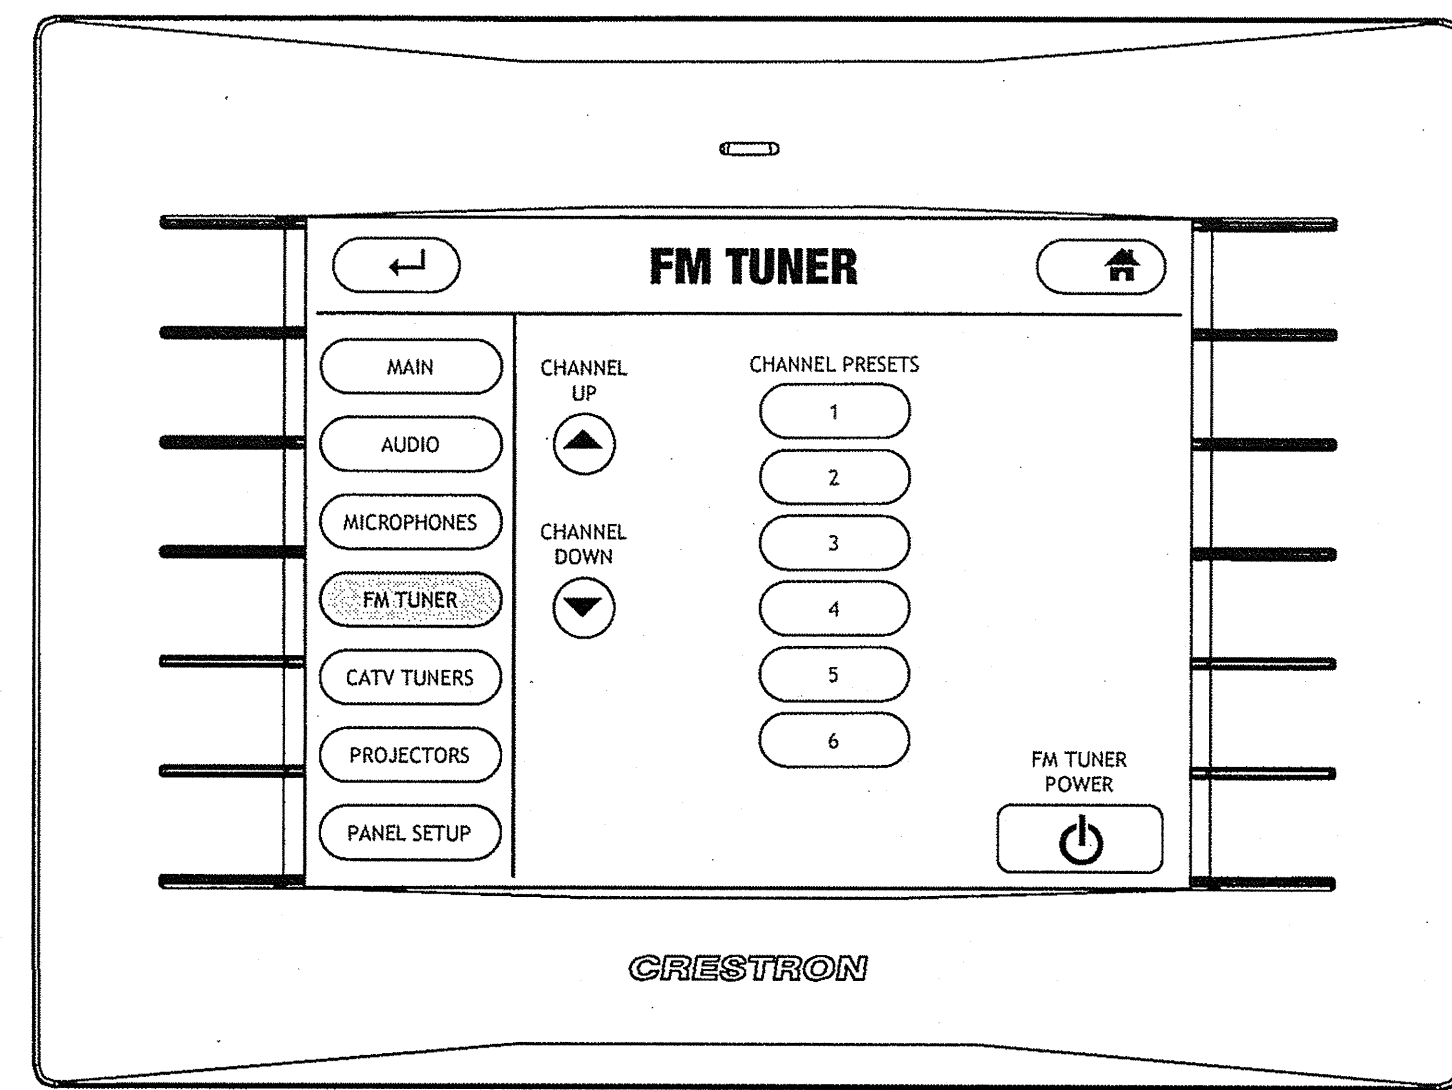


4 TOUCH PANEL TP-1 (FM TUNER)
NO SCALE

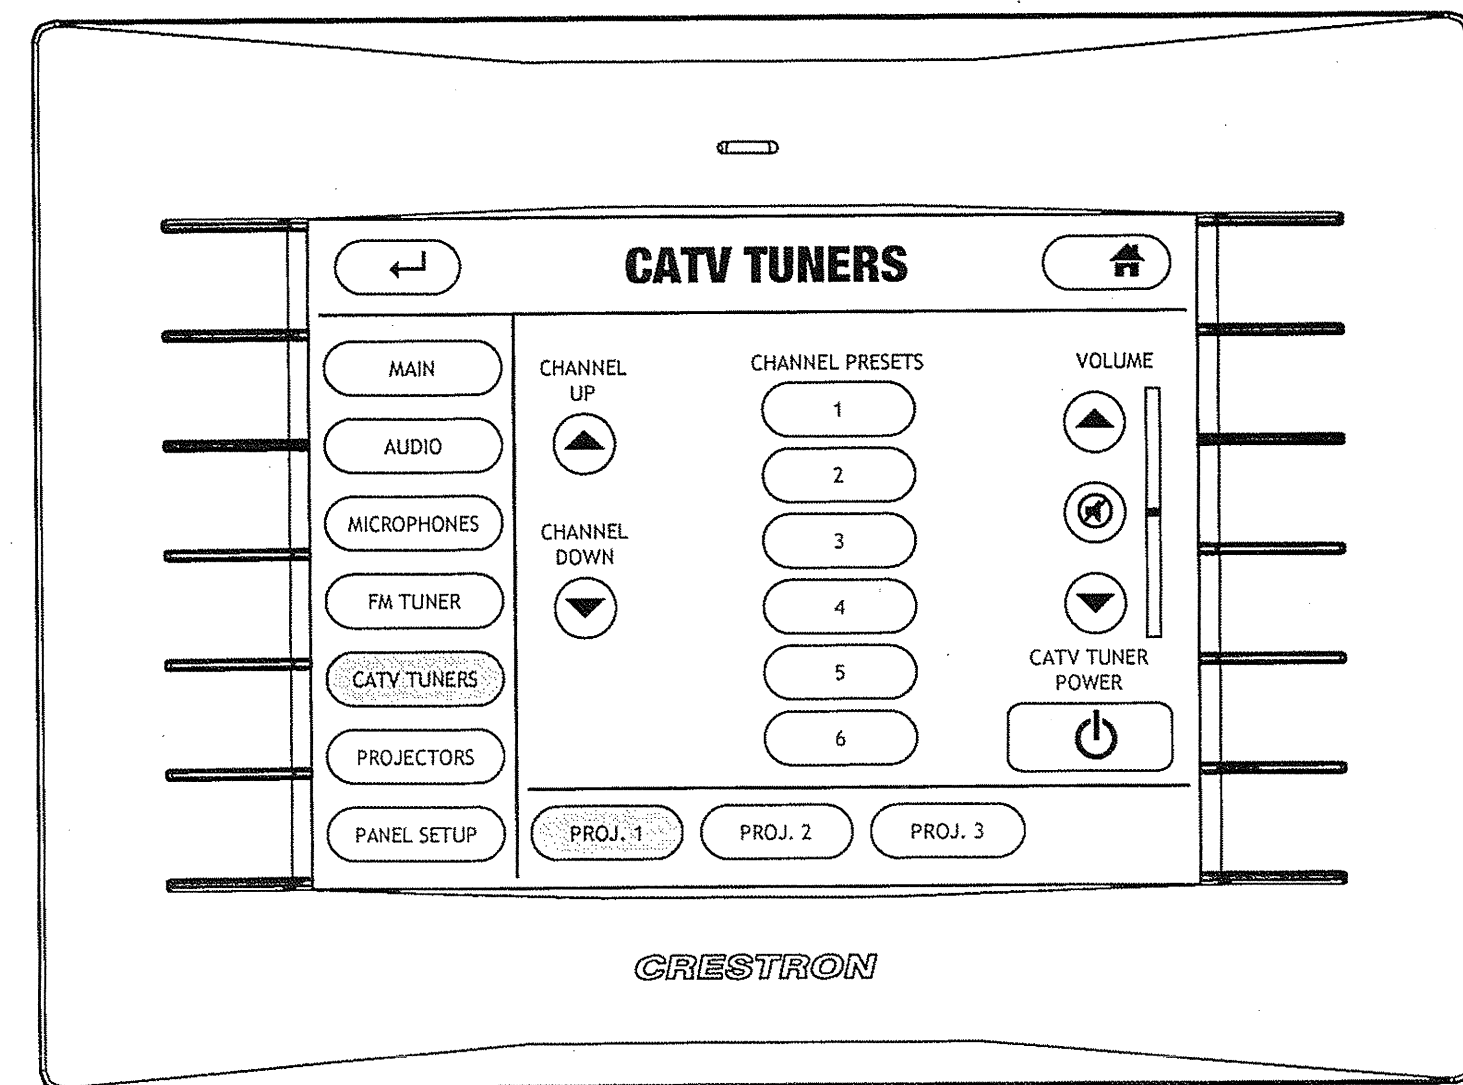


5 TOUCH PANEL TP-1 (CATV TUNERS)
NO SCALE

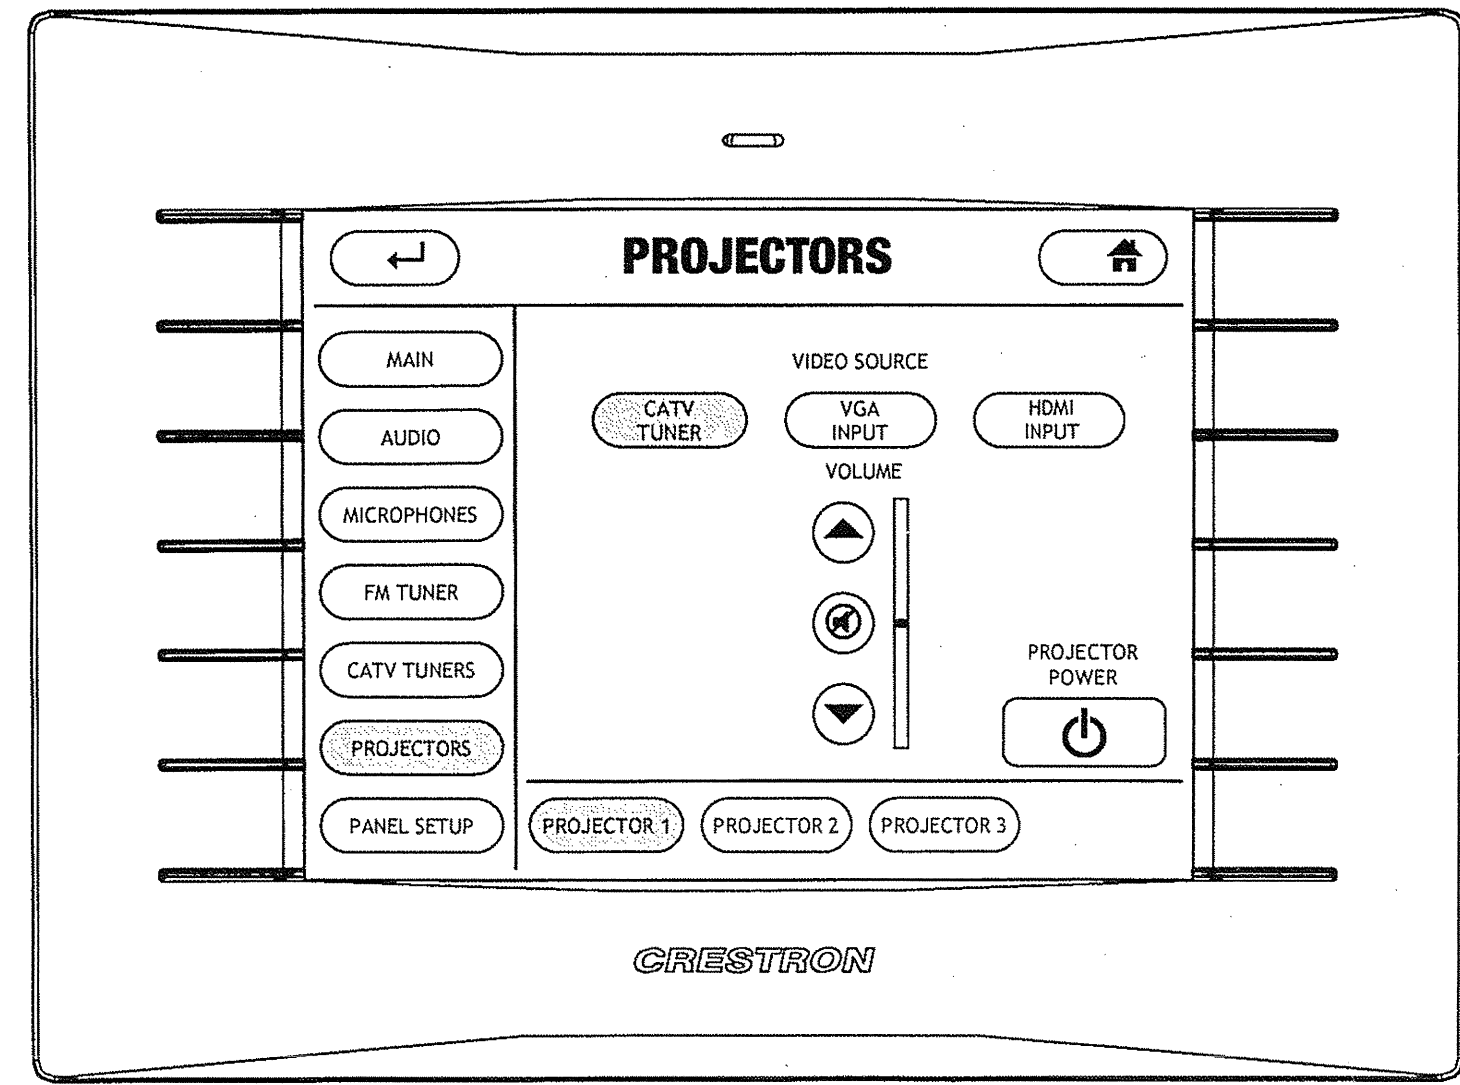

6 TOUCH PANEL TP-1 (PROJECTORS)
NO SCALE

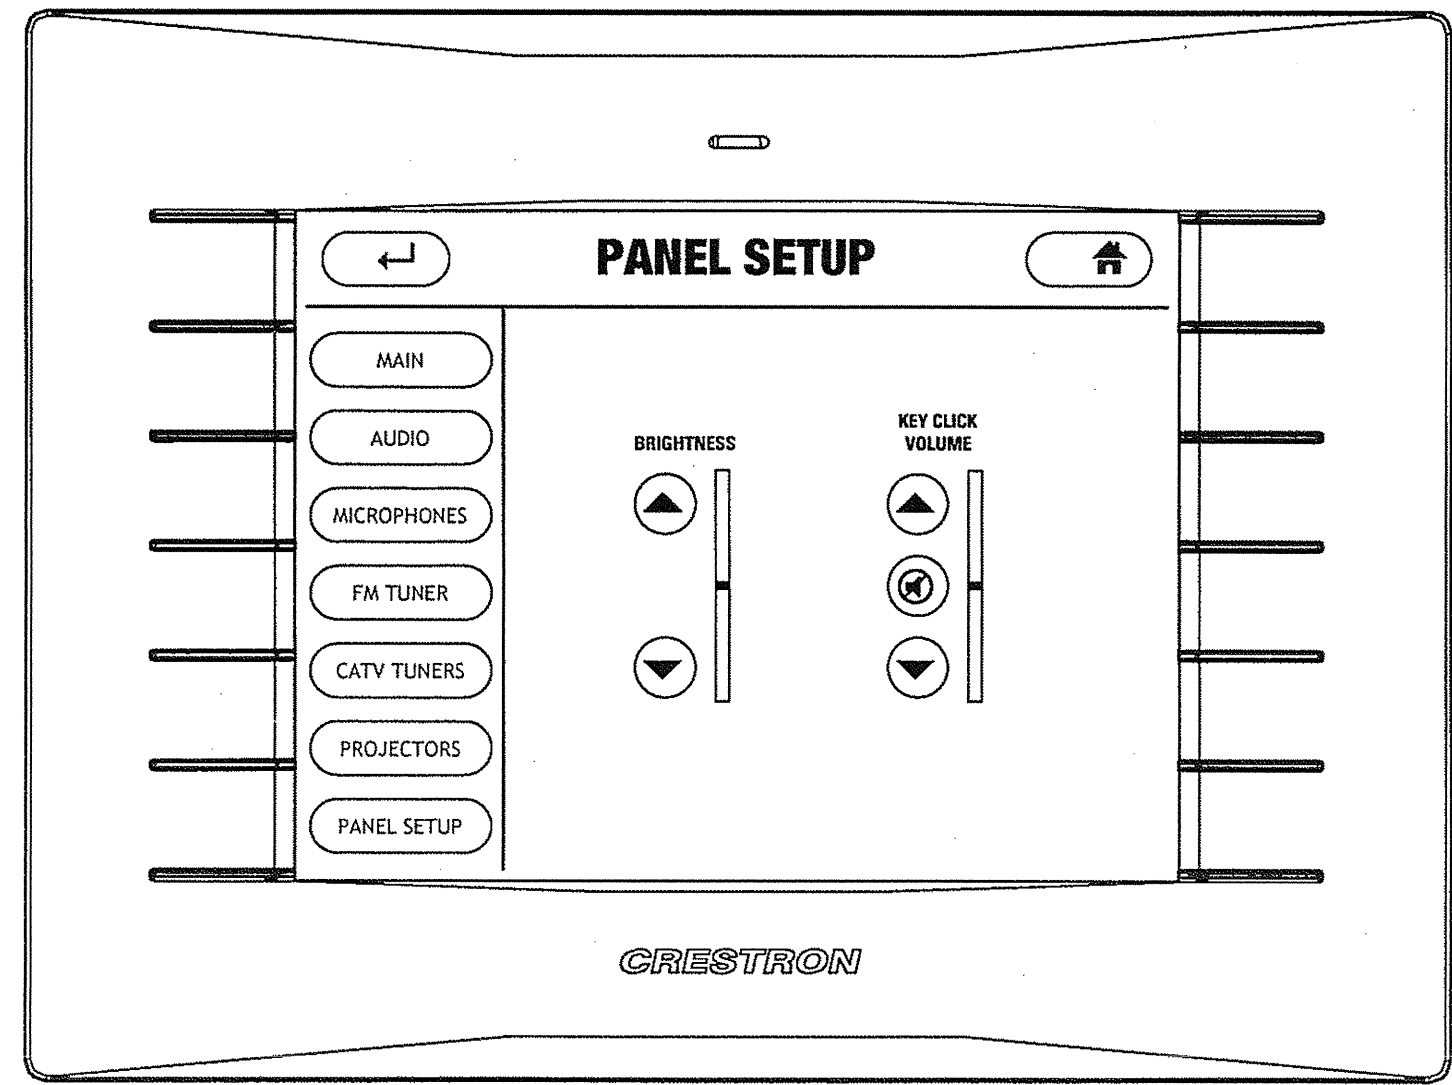


7 TOUCH PANEL TP-1 (PANEL SETUP)
NO SCALE

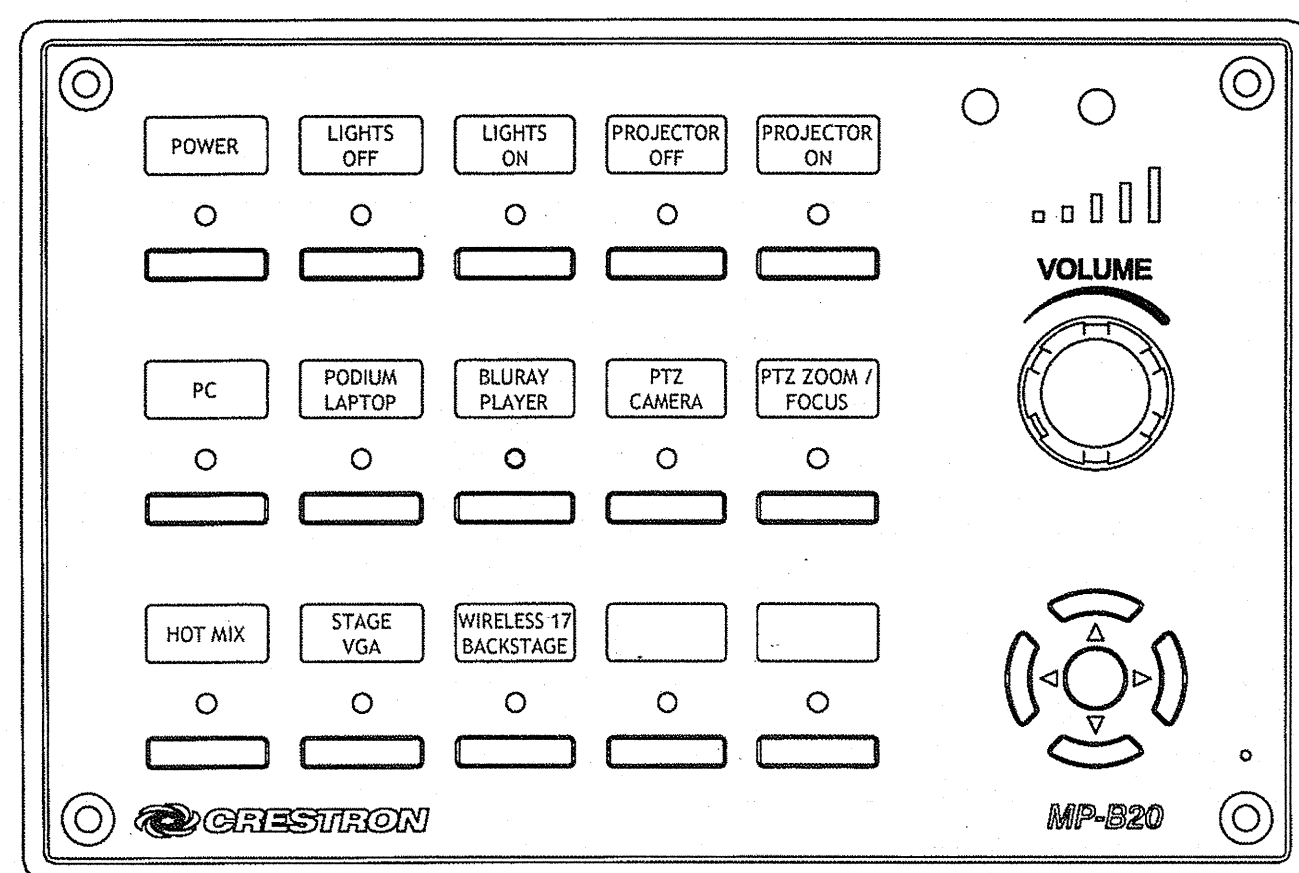


NOTES:
1. PROJECTOR ON BUTTON IS TO ALSO LOWER SCREEN.
2. PROJECTOR OFF BUTTON IS TO ALSO RAISE SCREEN.
3. PTZ CAMERA CONTROLS PAN AND TILT FUNCTIONS.
4. WIRELESS 17 ROUTES WIRELESS MIC 17 TO BACKSTAGE AND MUTES OTHER SOURCES.
5. STAGE VGA SWITCHES AUTO SWITCHER INPUTS.
6. HOT MIX CONTROLS VOLUME.

8 TP-2 (IN AER-I)
NO SCALE

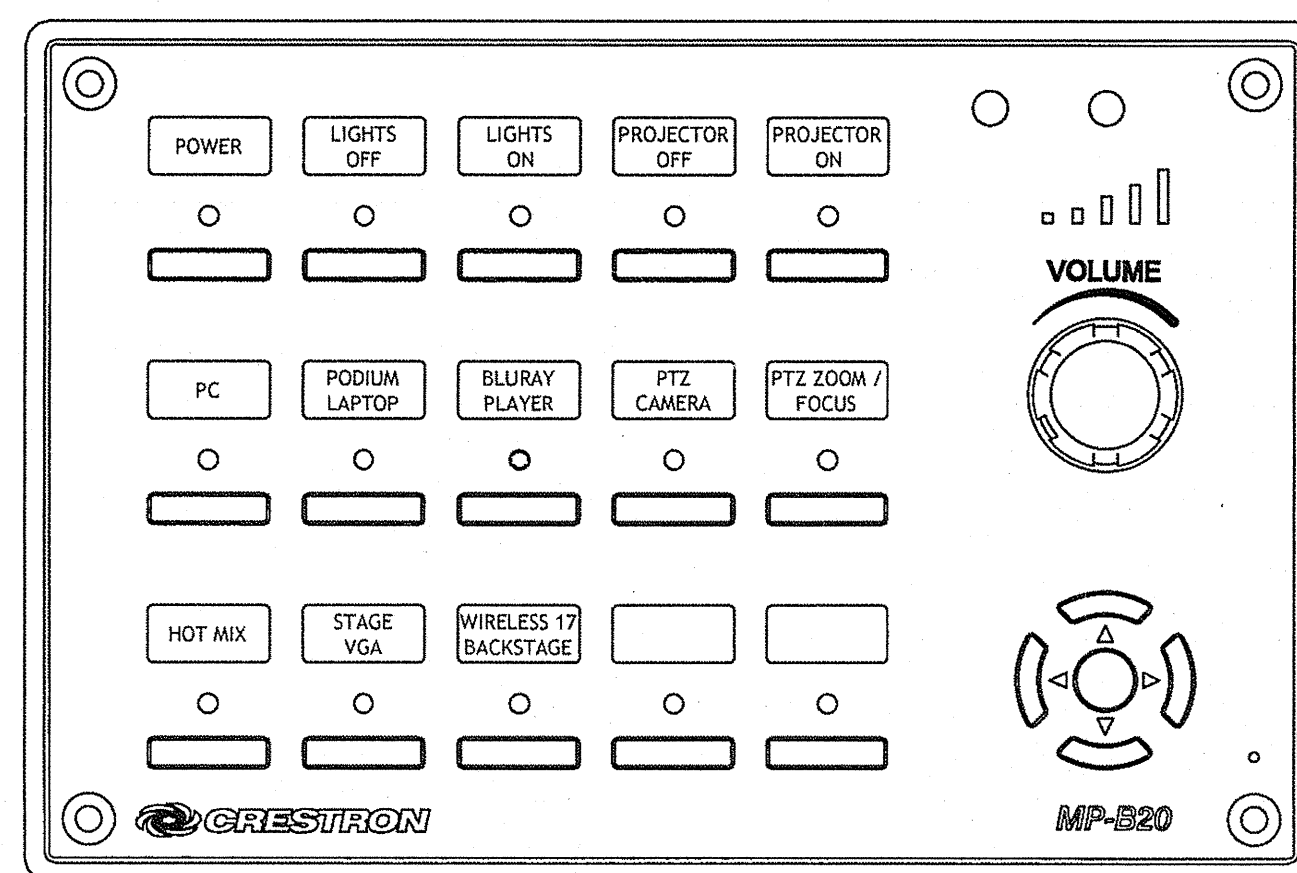

NOTES:
1. PROJECTOR ON BUTTON IS TO ALSO LOWER SCREEN.
2. PROJECTOR OFF BUTTON IS TO ALSO RAISE SCREEN.
3. PTZ CAMERA CONTROLS PAN AND TILT FUNCTIONS.
4. WIRELESS 17 ROUTES WIRELESS MIC 17 TO BACKSTAGE AND MUTES OTHER SOURCES.
5. STAGE VGA SWITCHES AUTO SWITCHER INPUTS.
6. HOT MIX CONTROLS VOLUME.

9 TP-3 (IN SMP)
NO SCALE

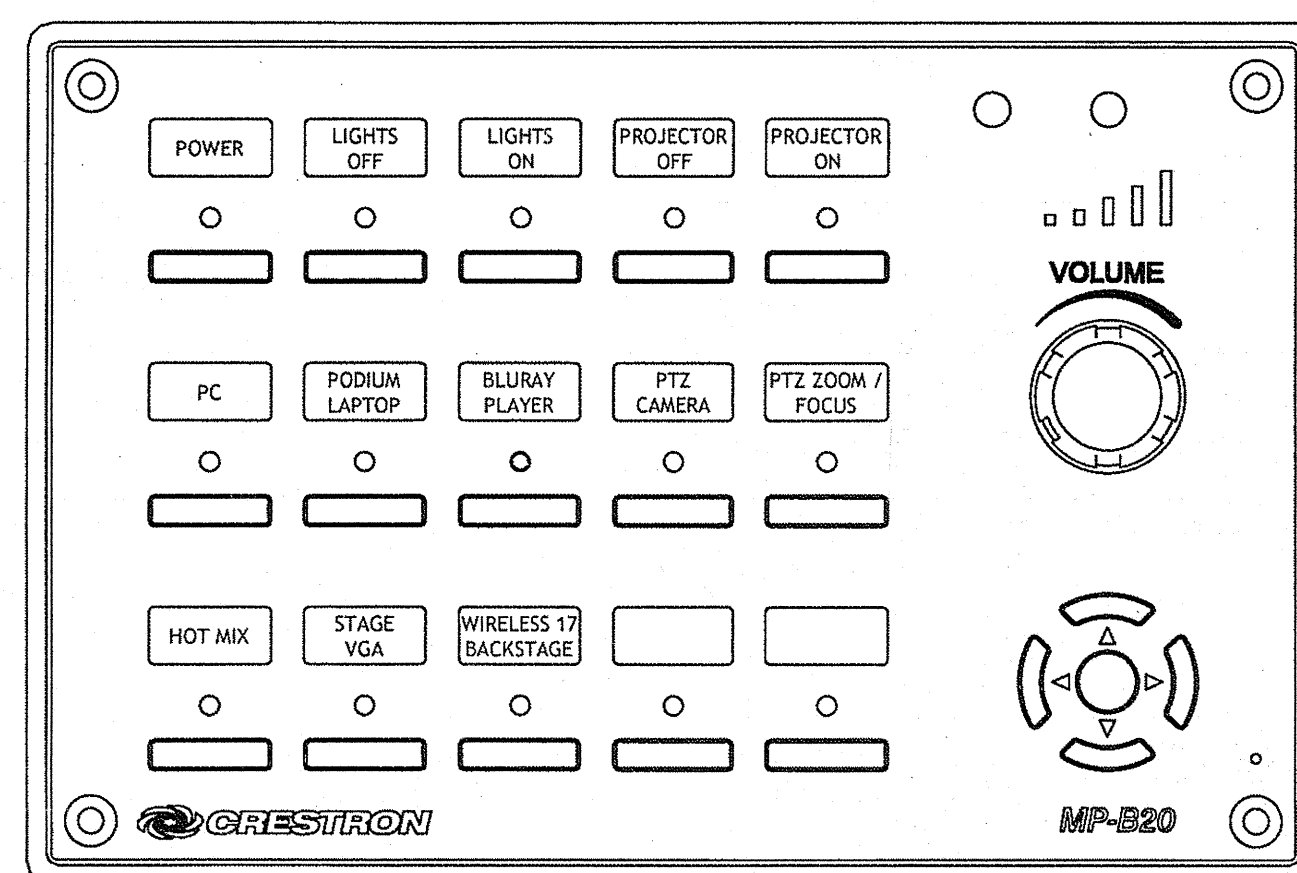


NOTES:
1. PROJECTOR ON BUTTON IS TO ALSO LOWER SCREEN.
2. PROJECTOR OFF BUTTON IS TO ALSO RAISE SCREEN.
3. PTZ CAMERA CONTROLS PAN AND TILT FUNCTIONS.
4. WIRELESS 17 ROUTES WIRELESS MIC 17 TO BACKSTAGE AND MUTES OTHER SOURCES.
5. STAGE VGA SWITCHES AUTO SWITCHER INPUTS.
6. HOT MIX CONTROLS VOLUME.

10 TP-4 (ON OFF PODIUM)
NO SCALE

| DATES OF ISSUE | |
|----------------|--------|
| NO. | DATE |
| 1 | 5-7-09 |
| 2 | 5-7-09 |
| 3 | 5-7-09 |
Copyright 2009 Acoustics By Design, Inc. All information on this drawing is the exclusive property of Acoustics By Design, Inc. and is furnished for use on the above project only. No part of this drawing may be duplicated without written consent from Acoustics By Design, Inc.

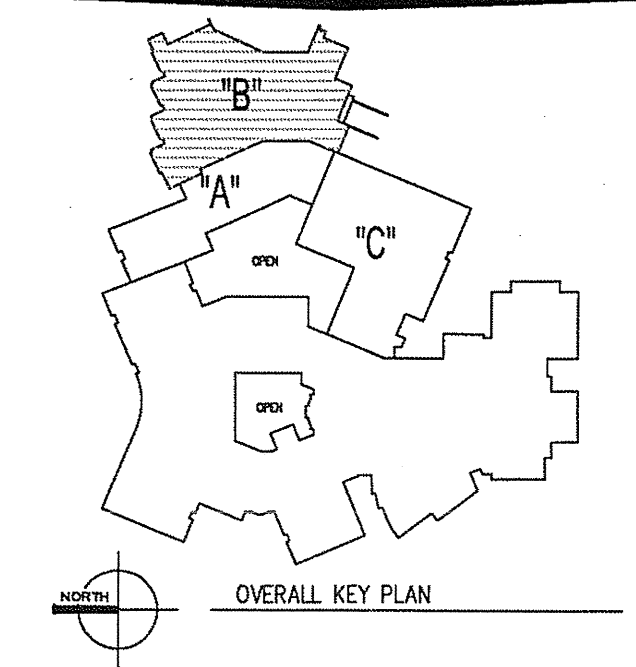

WAYLAND HIGH SCHOOL

HIGH SCHOOL ADDITIONS AND REMODELING

WAYLAND, MICHIGAN

Designed by: TGH, SS
Drawn by: DWB
Checked by: TGH, SS
Date Drawn: 04-16-2009
Sheet Title: AUDITORIUM TOUCH PANEL LAYOUTS

Sheet No. 12 of 16
Drawing Scale: 1/8" = 1'-0"

AV501