


No part of this drawing may be reproduced in any form or by any means, stored in a database or retrieval system, without written permission of CMB Architecture + Engineering.

9:15-1282-10-1032600.dgn
PLOT DATE / TIME 6/25/2009 6:48:00 AM

SC0119

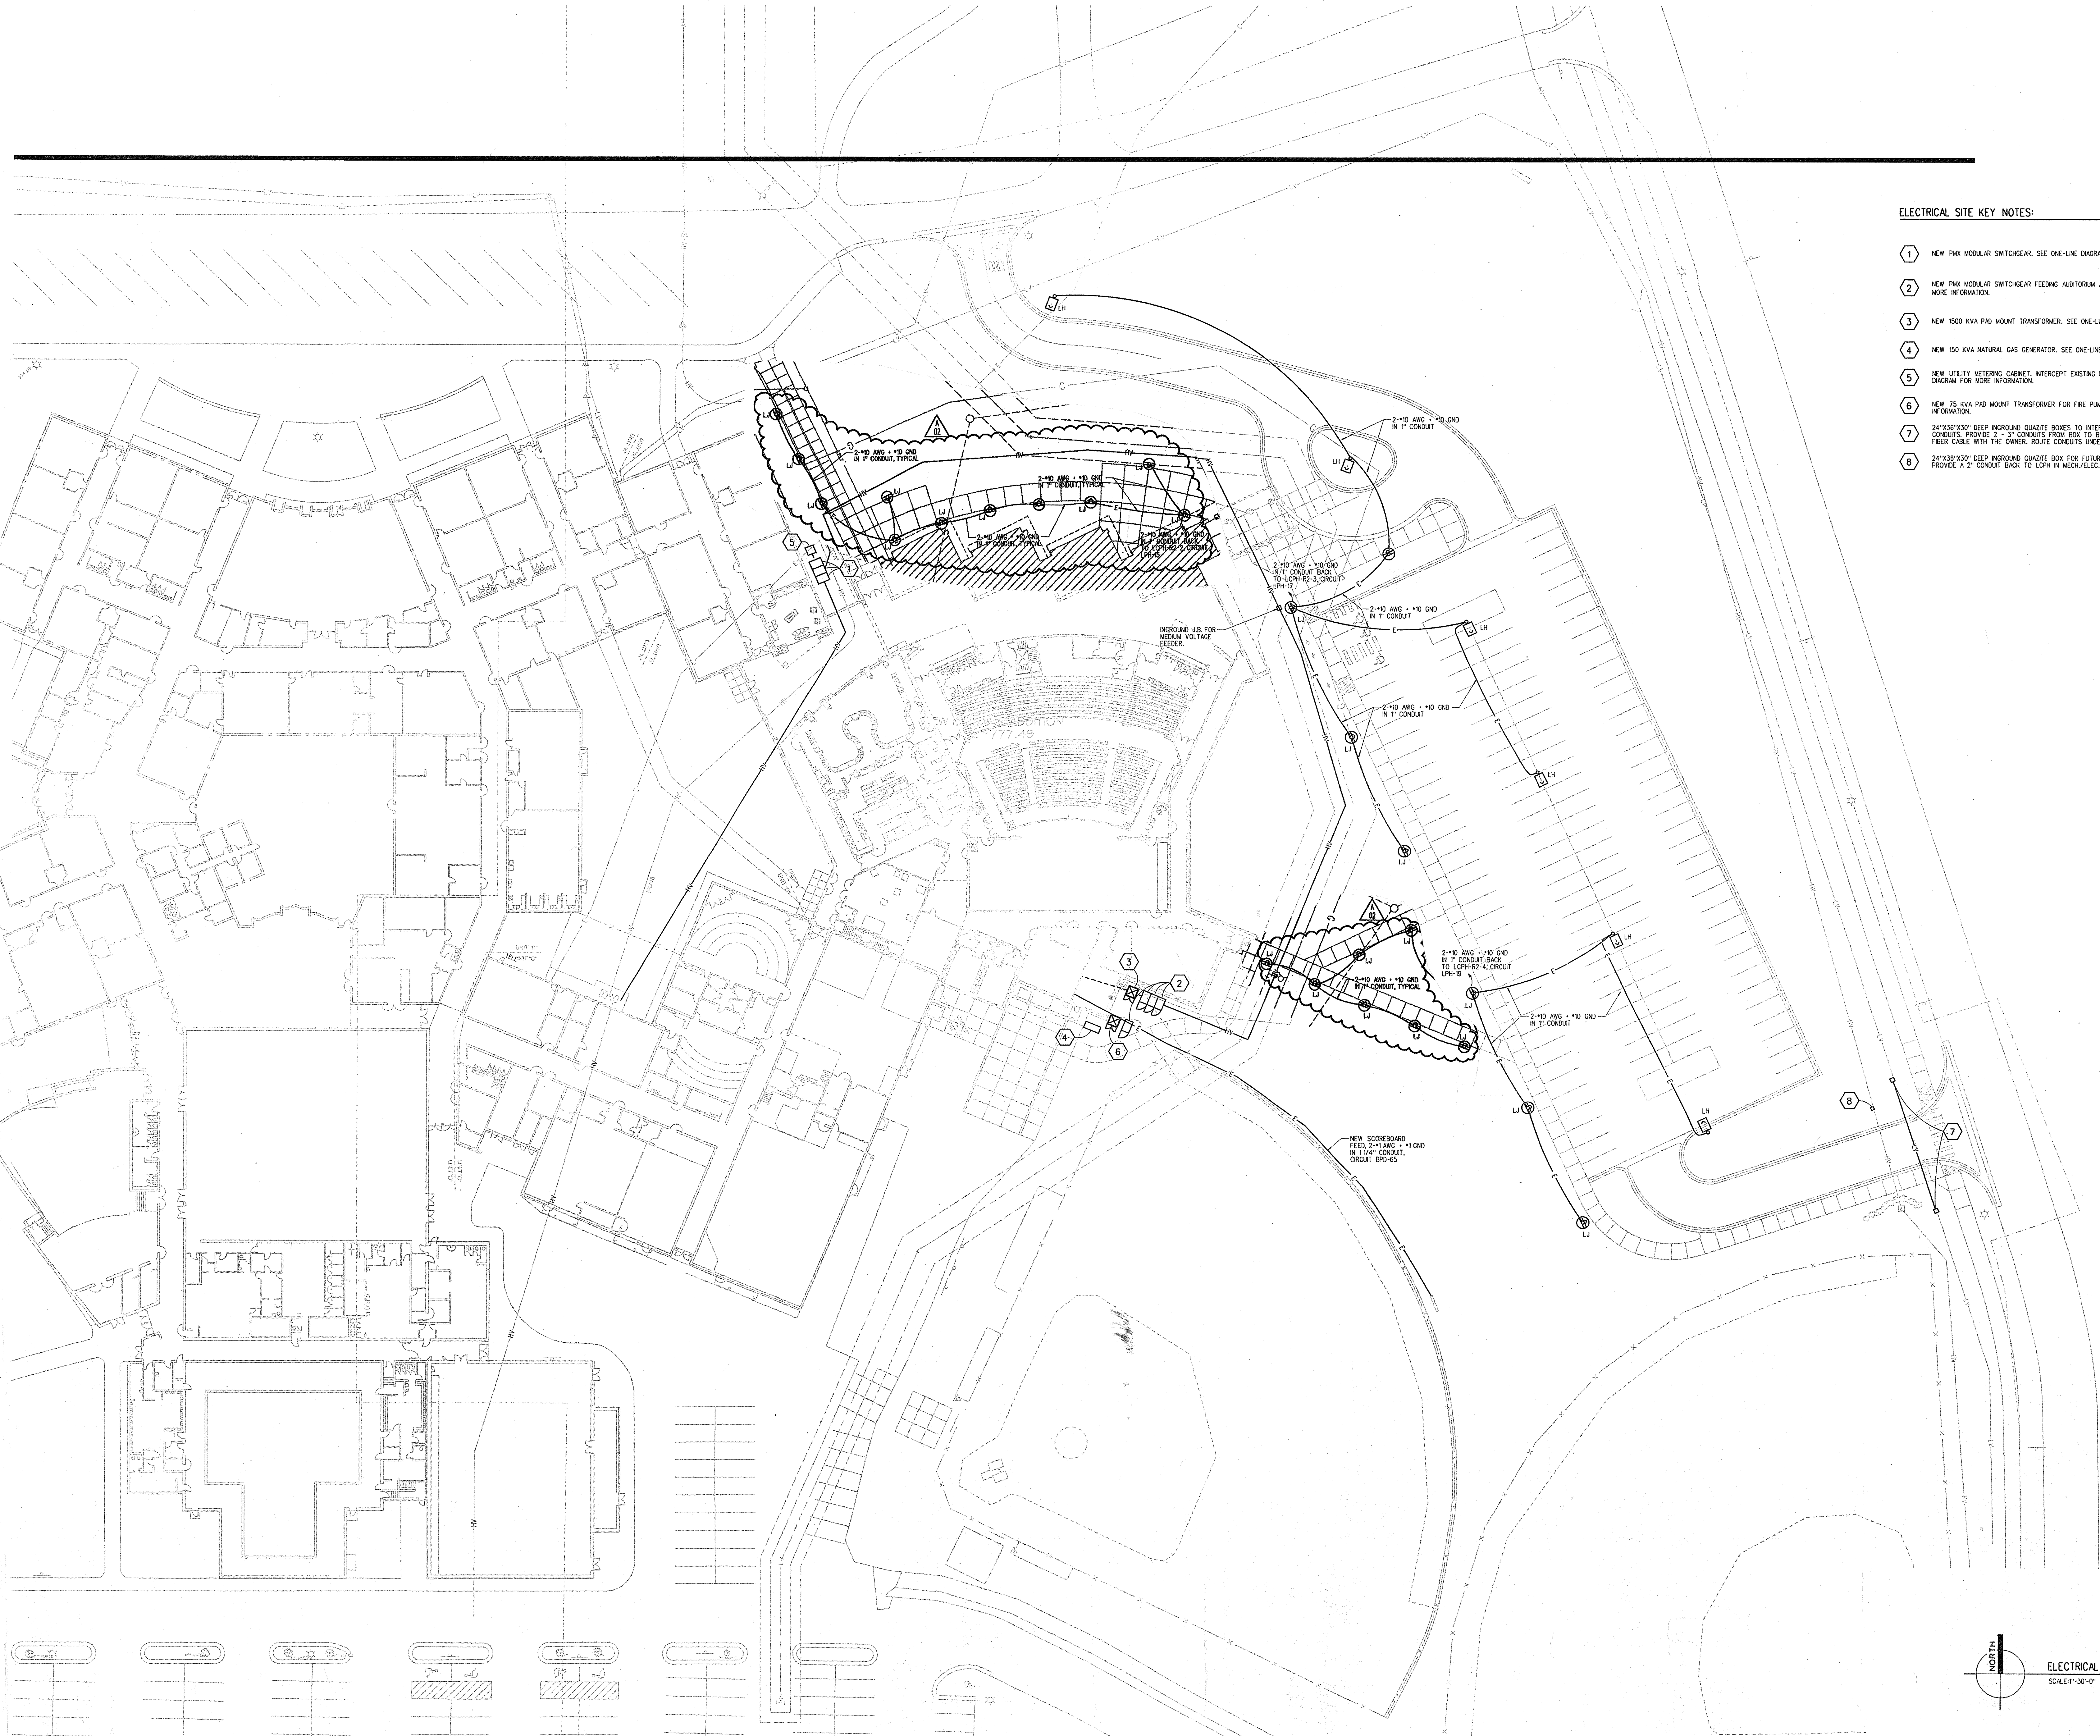

ELECTRICAL SITE KEY NOTES:


- 1 NEW PMX MODULAR SWITCHGEAR. SEE ONE-LINE DIAGRAM FOR MORE INFORMATION.
- 2 NEW PMX MODULAR SWITCHGEAR FEEDING AUDITORIUM ADDITION. SEE ONE-LINE DIAGRAM FOR MORE INFORMATION.
- 3 NEW 1500 KVA PAD MOUNT TRANSFORMER. SEE ONE-LINE DIAGRAM FOR MORE INFORMATION.
- 4 NEW 150 KVA NATURAL GAS GENERATOR. SEE ONE-LINE DIAGRAM FOR MORE INFORMATION.
- 5 NEW UTILITY METERING CABINET. INTERCEPT EXISTING PRIMARY FEED. SEE ONE-LINE DIAGRAM FOR MORE INFORMATION.
- 6 NEW 75 KVA PAD MOUNT TRANSFORMER FOR FIRE PUMP. SEE ONE-LINE DIAGRAM FOR MORE INFORMATION.
- 7 24"x36"x30" DEEP INGROUND QUARTZITE BOXES TO INTERCEPT EXISTING FIBER OPTIC CABLE CONDUITS. PROVIDE 2 - 3" CONDUITS FROM BOX TO BOX. COORDINATE PULLING BACK FIBER CABLE WITH THE OWNER. ROUTE CONDUITS UNDER NEW DRIVE.
- 8 24"x36"x30" DEEP INGROUND QUARTZITE BOX FOR FUTURE LIGHTING DOWN WILDCAT DRIVE. PROVIDE A 2" CONDUIT BACK TO LCPH IN MECH/ELEC. B27.

FINE ARTS CENTER ADDITION
WAYLAND UNION SCHOOLS
WAYLAND, MICHIGAN

PROJECT NO. 5-1282
Copyright © 2009
CMB Architecture + Engineering
All Rights Reserved

ELECTRICAL
SITE PLAN

E1.01

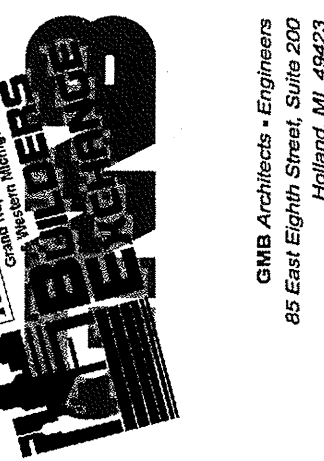

REVISIONS	ISSUANCES	DATE	BY	CHKD

ELECTRICAL SITE PLAN
SCALE: 1"=30'-0"