


GMB Architects • Engineers
85 East Eighth Street
Suite 200
Holland, MI 49423-3528
Phone: 616.796.0200
Fax: 616.796.0201



Fine Arts Center Addition

Wayland Union Schools
870 East Superior
Wayland, Michigan 49348

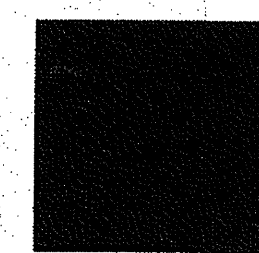

Site

C0.00 OVERALL EXISTING SITE SURVEY
C0.01 EAST DEMOLITION PLAN
C1.01 EAST SITE PLAN
C1.02 PERMEABLE PARKING LOT LAYOUT AND DETAILS
C1.03 ENLARGED SITE PLANS
C2.01 EAST DIMENSION PLAN
C3.01 EAST UTILITY PLAN
C3.02 NORTH UTILITY PLAN
C4.01 EAST LANDSCAPE AND S.E.C. PLAN
C7.01 SITE DETAILS
D0.0 WATERMAIN PLAN AND PROFILE
D0.01 WATERMAIN PLAN AND PROFILE

Keying

K.P.1A BAKER ELEMENTARY FLOOR PLAN - UNIT 'A'
K.P.1B BAKER ELEMENTARY FLOOR PLAN - UNIT 'B'
K.P.5 BAKER ELEMENTARY DOOR SCHEDULE
K.C.1A DORR ELEMENTARY FLOOR PLAN - UNIT 'A'
K.C.1B DORR ELEMENTARY FLOOR PLAN - UNIT 'B'
K.C.1C DORR ELEMENTARY FLOOR PLAN - UNIT 'C'
K.C.5 DORR ELEMENTARY DOOR SCHEDULE
K.H.S1C HIGH SCHOOL FIRST FLOOR PLAN - UNIT 'C'
K.H.S1D HIGH SCHOOL FIRST FLOOR PLAN - UNIT 'D'
K.H.S1E HIGH SCHOOL FIRST FLOOR PLAN - UNIT 'E'
K.H.S1F HIGH SCHOOL FIRST FLOOR PLAN - UNIT 'F'
K.H.S1G HIGH SCHOOL FIRST FLOOR PLAN - UNIT 'G'
K.H.S1H HIGH SCHOOL FIRST FLOOR PLAN - UNIT 'H'
K.H.S1J HIGH SCHOOL FIRST FLOOR PLAN - UNIT 'J'
K.H.S1K HIGH SCHOOL FIRST FLOOR PLAN - UNIT 'K'
K.H.S2C HIGH SCHOOL SECOND FLOOR PLAN - UNIT 'C'
K.H.S2D HIGH SCHOOL SECOND FLOOR PLAN - UNIT 'D'
K.H.S5 HIGH SCHOOL DOOR SCHEDULE
K.M.S5 MIDDLE SCHOOL DOOR SCHEDULE AND FLOOR PLAN
K.P.1A PINE STREET FIRST FLOOR PLAN - UNIT 'A'
K.P.1B PINE STREET FIRST FLOOR PLAN - UNIT 'B'
K.P.2A PINE STREET SECOND FLOOR PLAN - UNIT 'A'
K.P.2B PINE STREET SECOND FLOOR PLAN - UNIT 'B'
K.P.5 PINE STREET DOOR SCHEDULE
K.S.1A STEEBY ELEMENTARY FLOOR PLAN - UNIT 'A'
K.S.1B STEEBY ELEMENTARY FLOOR PLAN - UNIT 'B'
K.S.5 STEEBY ELEMENTARY DOOR SCHEDULE

Architectural

A0.01 FIRST FLOOR CODE COMPLIANCE PLAN
A0.02 SECOND FLOOR CODE COMPLIANCE PLAN
A0.1A UNIT 'A' & 'C' DEMOLITION PLAN
A1.01 LEVEL 1 OVERALL FLOOR PLAN
A1.02 OVERALL ROOF PLAN
A2.1A LEVEL 1 UNIT 'A' FLOOR PLAN
A2.1B LEVEL 1 UNIT 'B' FLOOR PLAN
A2.2A LEVEL 2 UNIT 'A' FLOOR PLAN
A2.2B LEVEL 2 UNIT 'B' FLOOR PLAN
A2.2B UNIT 'B' CATWALK PLAN
A2.31 ENLARGED PARTIAL PLANS
A2.32 ENLARGED RIGGING PLAN / SECTION
A2.33 ENLARGED SEATING LAYOUT PLAN
A3.1A LEVEL 1 UNIT 'A' REFLECTED CEILING PLAN
A3.1B LEVEL 1 UNIT 'B' REFLECTED CEILING PLAN
A3.2B LEVEL 2 UNIT 'B' REFLECTED CEILING PLAN
A4.01 EXTERIOR ELEVATIONS
A4.02 EXTERIOR ELEVATIONS
A5.01 DOOR & FRAME SCHEDULE
A5.02 FRAME SCHEDULE
A6.01 BUILDING SECTIONS
A6.02 BUILDING SECTIONS
A6.03 BUILDING SECTIONS
A6.04 BUILDING SECTIONS
A6.10 WALL SECTIONS
A6.11 WALL SECTIONS
A6.12 WALL SECTIONS
A6.20 STAIR AND ELEVATOR SECTIONS
A6.21 STAIR SECTIONS
A7.01 DOOR AND FRAME DETAILS
A7.02 DETAILS
A7.03 DETAILS
A7.04 DETAILS
A7.51 STAGE AND MILLWORK DETAILS
A8.01 INTERIOR ELEVATIONS
A8.02 INTERIOR ELEVATIONS
A8.03 INTERIOR ELEVATIONS
A8.04 INTERIOR ELEVATIONS
A8.05 INTERIOR ELEVATIONS
A8.06 INTERIOR ELEVATIONS
A8.07 INTERIOR ELEVATIONS
A8.1A UNIT 'A' FLOOR COVERING PLAN
A8.1B UNIT 'B' FLOOR COVERING PLAN
A9.10 ROOM FINISH SCHEDULE

Structural

S2.01 OVERALL FOUNDATION PLAN
S2.1A UNIT 'A' FOUNDATION PLAN
S2.1B UNIT 'B' FOUNDATION PLAN
S3.1A UNIT 'A' LOWER LEVEL FRAMING PLAN
S3.1B UNIT 'B' LOWER LEVEL FRAMING PLAN
S3.2A UNIT 'A' INTERMEDIATE LEVEL FRAMING PLAN
S3.2B UNIT 'B' INTERMEDIATE LEVEL FRAMING PLAN
S3.3B UNIT 'B' UPPER LEVEL FRAMING PLAN
S7.01 STRUCTURAL DETAILS
S7.02 STRUCTURAL DETAILS

Mechanical

M0.1A UNIT 'A' & 'C' FIRST FLOOR DEMOLITION PLAN
M2.1A UNIT 'A' FIRST FLOOR HVAC PLAN
M2.1B UNIT 'B' FIRST FLOOR HVAC PLAN
M2.2B UNIT 'B' SECOND FLOOR HVAC PLAN
M2.3B UNIT 'B' CATWALK HVAC PLAN
M2.80 ENLARGED MECHANICAL PLANS
M2.FS1 ENLARGED FOOD SERVICE HVAC PLAN
M2.FS2 KITCHEN EQUIPMENT
M2.FS3 KITCHEN EQUIPMENT
M2.FS4 KITCHEN EQUIPMENT SECTIONS
M2.FS5 KITCHEN EQUIPMENT SECTIONS
M3.00 PARTIAL OVERALL HOT WATER PIPING PLAN
M3.1A UNIT 'A' FIRST FLOOR HYDRONIC PLAN
M3.1B UNIT 'B' FIRST FLOOR HYDRONIC PLAN
M3.2B UNIT 'B' UPPER LEVEL HYDRONIC PLANS
M4.01 HYDRONIC FLOW SCHEMATIC
M5.01 GEOTHERMAL LOOP FIELD PIPING PLAN
M7.01 MECHANICAL DETAILS
M9.01 MECHANICAL EQUIPMENT SCHEDULE

Electrical

E0.01 ELECTRICAL SITE DEMOLITION PLAN
E0.1A UNIT 'A' AND 'C' FIRST FLOOR ELECTRICAL DEMOLITION PLAN
E1.01 ELECTRICAL SITE PLAN
E2.01 BAKER ELEMENTARY CARD ACCESS ELECTRICAL PLAN
E2.02 DORR ELEMENTARY CARD ACCESS ELECTRICAL PLAN
E2.03 PINE STREET ELEMENTARY CARD ACCESS ELECTRICAL PLAN
E2.04 STEEBY ELEMENTARY CARD ACCESS ELECTRICAL PLAN
E2.05 MIDDLE SCHOOL CARD ACCESS ELECTRICAL PLAN
E2.06 HIGH SCHOOL CARD ACCESS ELECTRICAL PLAN
E2.1A UNIT 'A' FIRST FLOOR POWER PLAN
E2.1B UNIT 'B' FIRST FLOOR POWER PLAN
E2.1C UNIT 'C' FIRST FLOOR POWER PLAN
E2.2B UNIT 'B' UPPER LEVEL POWER PLAN
E2.3B UNIT 'B' CATWALK POWER PLAN
E2.80 ENLARGED KITCHEN POWER PLAN
E2.81 ENLARGED MECHANICAL ROOM POWER PLANS
E3.01 LIGHTING FIXTURE SCHEDULE
E3.02 LIGHTING CONTROL WIRING DIAGRAMS
E3.1A UNIT 'A' FIRST FLOOR LIGHTING PLAN
E3.1B UNIT 'B' FIRST FLOOR LIGHTING PLAN
E3.2B UNIT 'B' UPPER LEVEL LIGHTING PLAN
E3.3B UNIT 'B' CATWALK LIGHTING PLAN
E4.01 ONE-LINE DIAGRAM
E5.01 PANELBOARD SCHEDULES
E5.02 PANELBOARD SCHEDULES
E7.01 SYMBOL LEGENDS & DETAILS
E7.02 ACCESS CONTROL DETAILS

Audio Visual / Theatrical Lighting

AV100 DETAILS / SYMBOLS / DIVISION OF LABOR
AV101 AUDIO MAIN SCHEMATIC AUDITORIUM
AV102 AUDIO SECONDARY SCHEMATIC AUDITORIUM
AV103 AUDIO / VIDEO SCHEMATIC LOBBY
AV201 AUDIO / VIDEO AUDITORIUM CONDUIT AND BOX LOCATIONS FLOOR PLAN
AV202 AUDIO / VIDEO AUDITORIUM CONDUIT AND BOX LOCATIONS BOOTH LEVEL PLAN
AV203 AUDIO / VIDEO AUDITORIUM CONDUIT AND BOX LOCATIONS CATWALK LEVEL PLAN
AV211 AUDIO / VIDEO DETAILS, LEGENDS, AND SCHEDULES
AV220 ILS AUDITORIUM CONDUIT AND BOX LOCATIONS FLOOR PLAN
AV301 AUDIO / VIDEO EQUIPMENT LOCATIONS AND DETAILS
AV401 RACK AND TECHNICAL POWER DETAILS
AV501 AUDITORIUM TOUCH PANEL LAYOUTS
TL100 THEATRICAL LIGHTING CONTROL SCHEMATIC
TL201 THEATRICAL LIGHTING FIRST FLOOR LOCATIONS
TL202 THEATRICAL LIGHTING SECOND FLOOR LOCATIONS
TL203 THEATRICAL LIGHTING CATWALK LEVEL LOCATIONS

Plumbing

P2.1A UNIT 'A' FIRST FLOOR PLAN - PLUMBING
P2.1B UNIT 'B' FIRST FLOOR PLAN - PLUMBING
P2.1C UNIT 'C' FIRST LEVEL PLAN - PLUMBING
P2.2B UNIT 'B' UPPER LEVEL PLAN - PLUMBING
P2.80 ENLARGED FLOOR PLANS
P2.81 ENLARGED FLOOR PLANS
P3.01 PLUMBING & SANITARY ISOMETRICS
P8.1A UNIT 'A' FIRST FLOOR PLAN - FIRE PROTECTION
P8.1B UNIT 'B' FIRST FLOOR PLAN - FIRE PROTECTION
P8.2B UNIT 'B' UPPER LEVEL PLAN - FIRE PROTECTION
P8.01 ENLARGED FLOOR PLAN & DETAILS

Food Service Equipment

FS1 FOOD SERVICE EQUIPMENT PLAN
FS2 FOOD SERVICE UTILITY SCHEDULES
FS3 FOOD SERVICE MECHANICAL PLAN
FS4 FOOD SERVICE ELECTRICAL PLAN
FS5 FOOD SERVICE DETAILS
FS6 FOOD SERVICE VENTILATION PLAN

2082

PLANS MUST BE RESERVED
CHECK OUT AT 4:30 PM
RETURN PLANS AT 8:00 AM
TO BUILDERS EXCHANGE
OF GRAND RAPIDS

40

Bids & Construction
June 24, 2009