


No part of this drawing may be reproduced in any form or by any means, except in a database or retrieval system, without written permission of OME Architecture - Engineering.

9\5-1282\5-1282\01\09p  
PLOT DATE / TIME 6/25/2009 6:48:05 AM

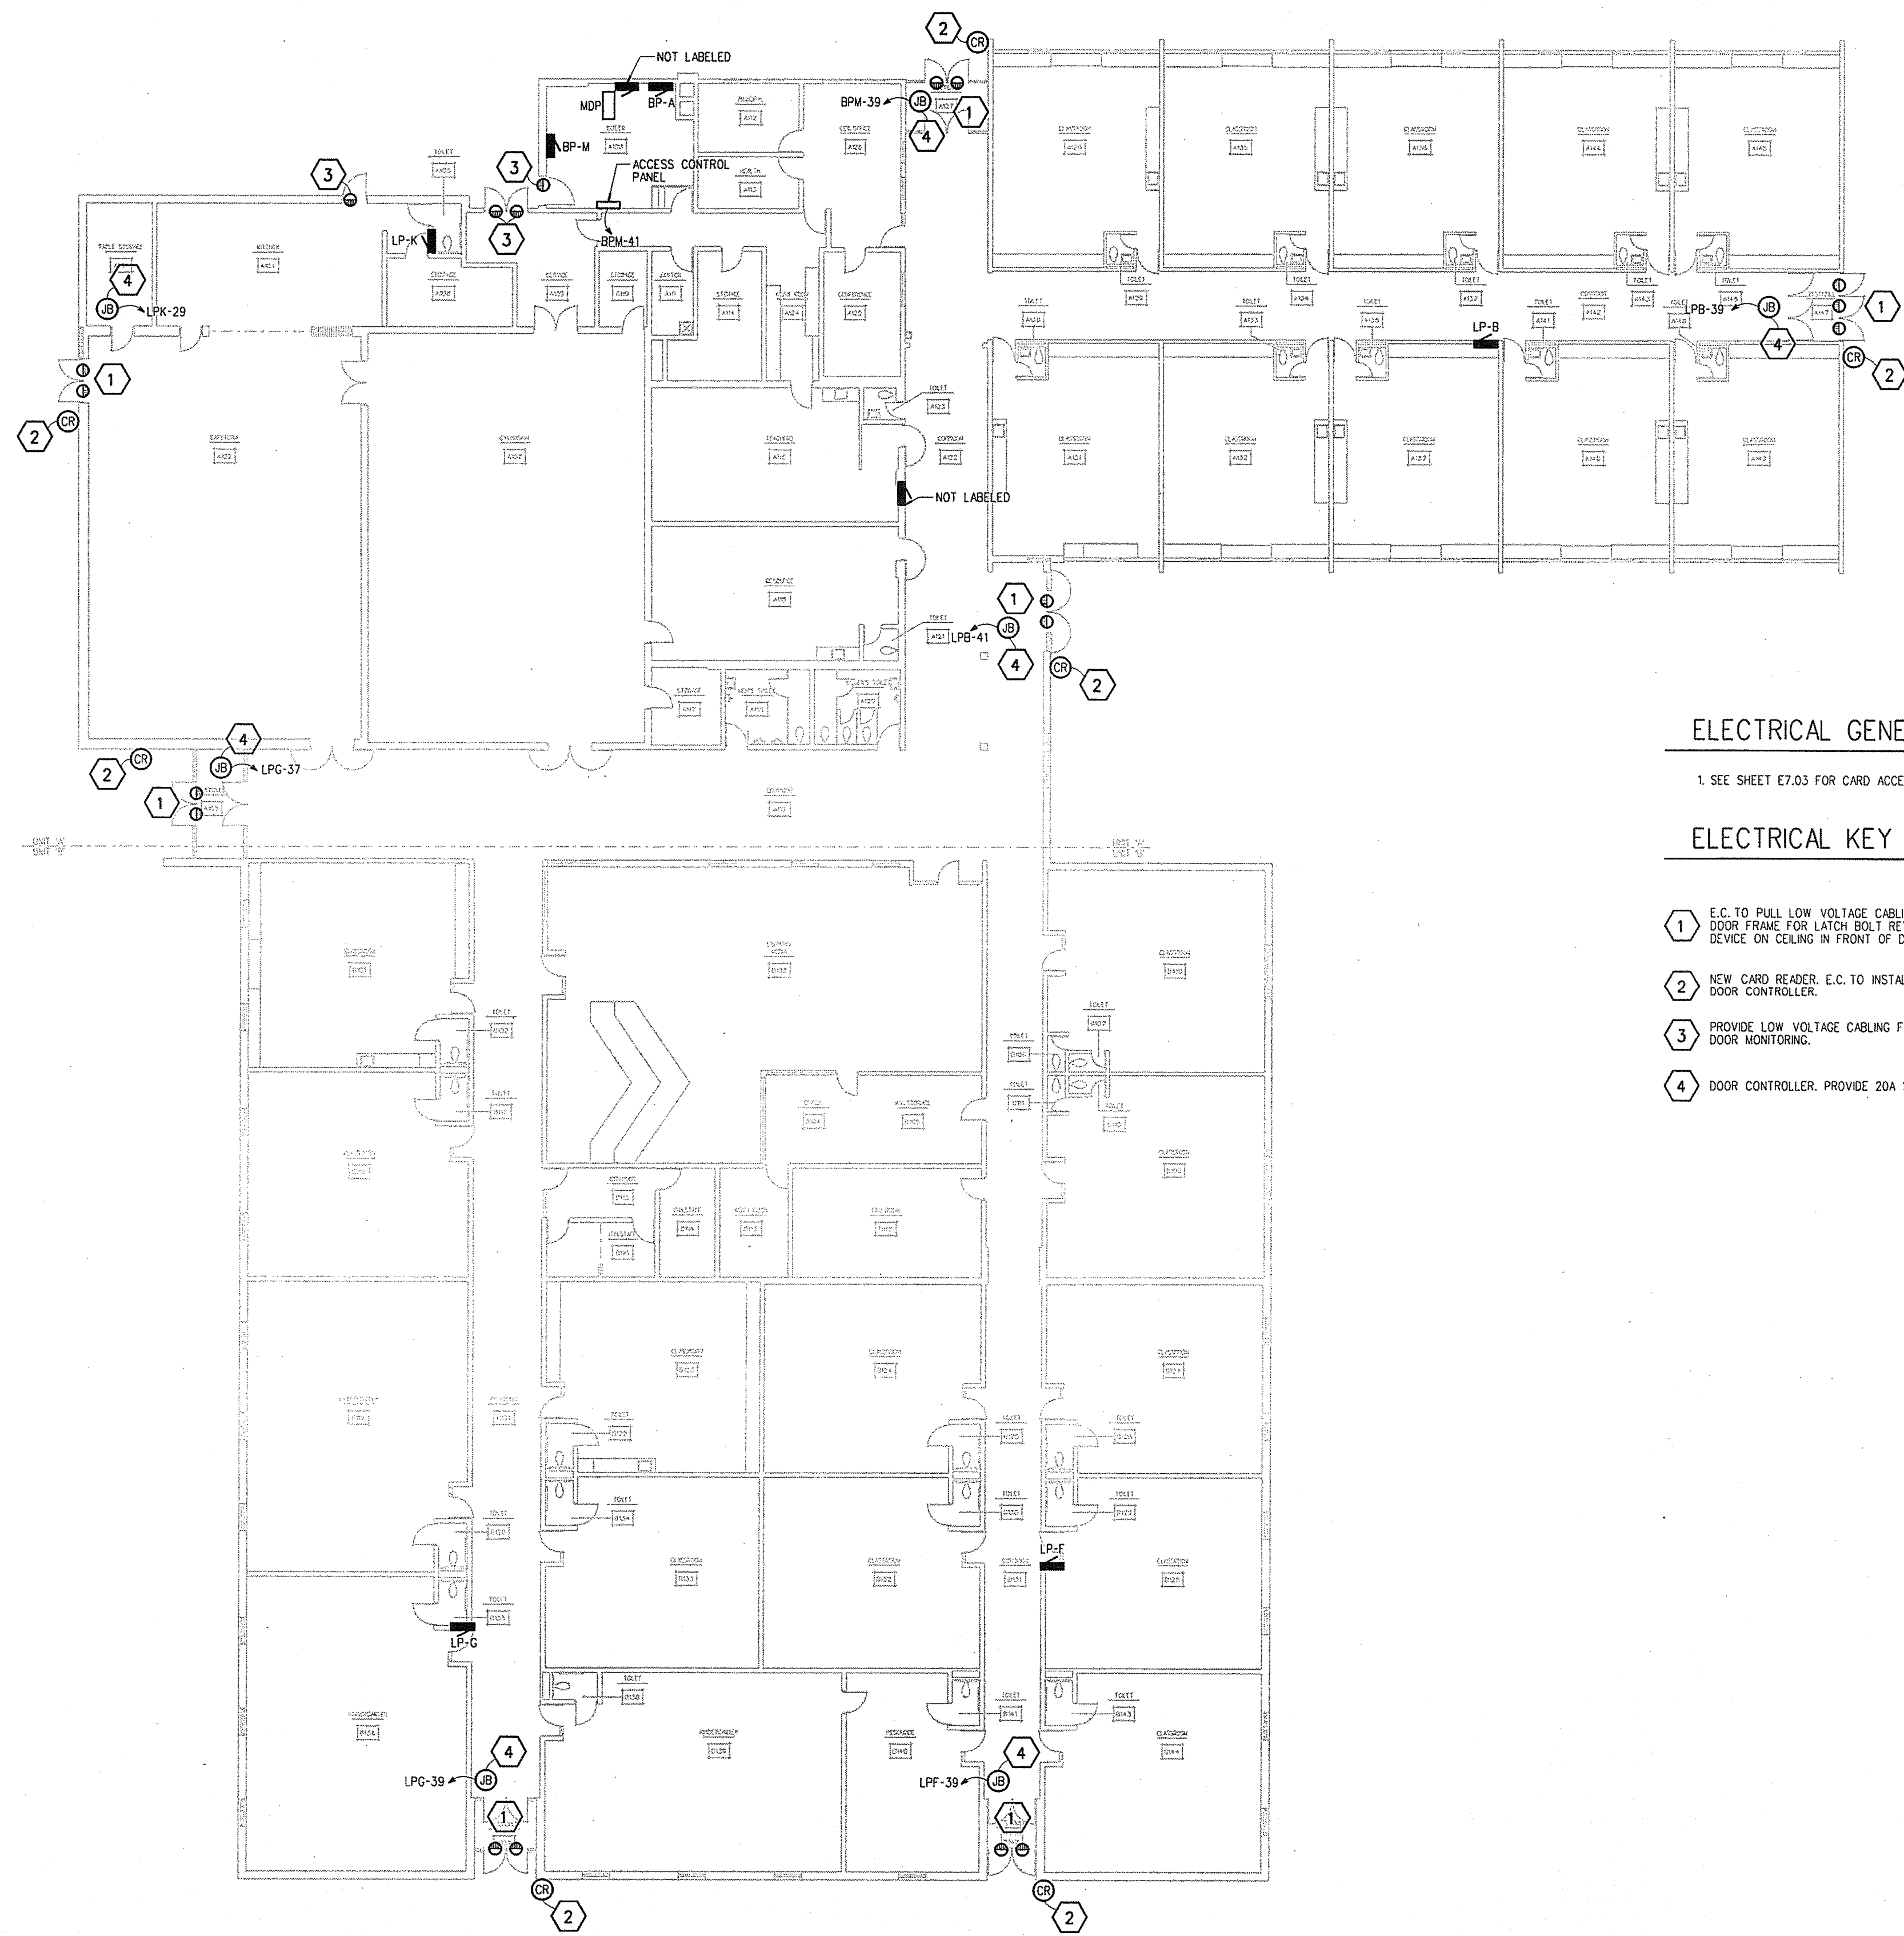


#### ELECTRICAL GENERAL NOTES

1. SEE SHEET E7.03 FOR CARD ACCESS DETAILS.

#### ELECTRICAL KEY NOTES: (THIS SHEET ONLY)

- ① E.C. TO PULL LOW VOLTAGE CABLING FROM DOOR CONTROLLER AND FISH DOWN MALLION OR DOOR FRAME FOR LATCH BOLT RETRACTION WITH BOLT DETECTION. INSTALL REQUEST TO EXIT DEVICE ON CEILING IN FRONT OF DOOR. PROVIDE CABLING IN WIREMOLD INTO DOOR FRAME.
- ② NEW CARD READER. E.C. TO INSTALL SINGLE GANG RECESSED BOX WITH LOW VOLTAGE CABLING FROM DOOR CONTROLLER.
- ③ PROVIDE LOW VOLTAGE CABLING FROM NEAREST DOOR CONTROLLER INTO DOOR FRAME FOR DOOR MONITORING.
- ④ DOOR CONTROLLER. PROVIDE 20A 120V POWER FROM SPECIFIED PANELBOARD.

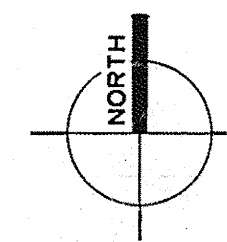

#### BAKER ELEMENTARY OVERALL ELECTRICAL PLAN

Scale: 1/8" = 1'