


No part of this drawing may be reproduced in any form or by any means, stored in a database or retrieval system without written permission of CMB Architecture + Engineering.

P:\5-1282\5-1282\203.dgn  
PLOT DATE / TIME 6/25/2009 6:48:06 AM

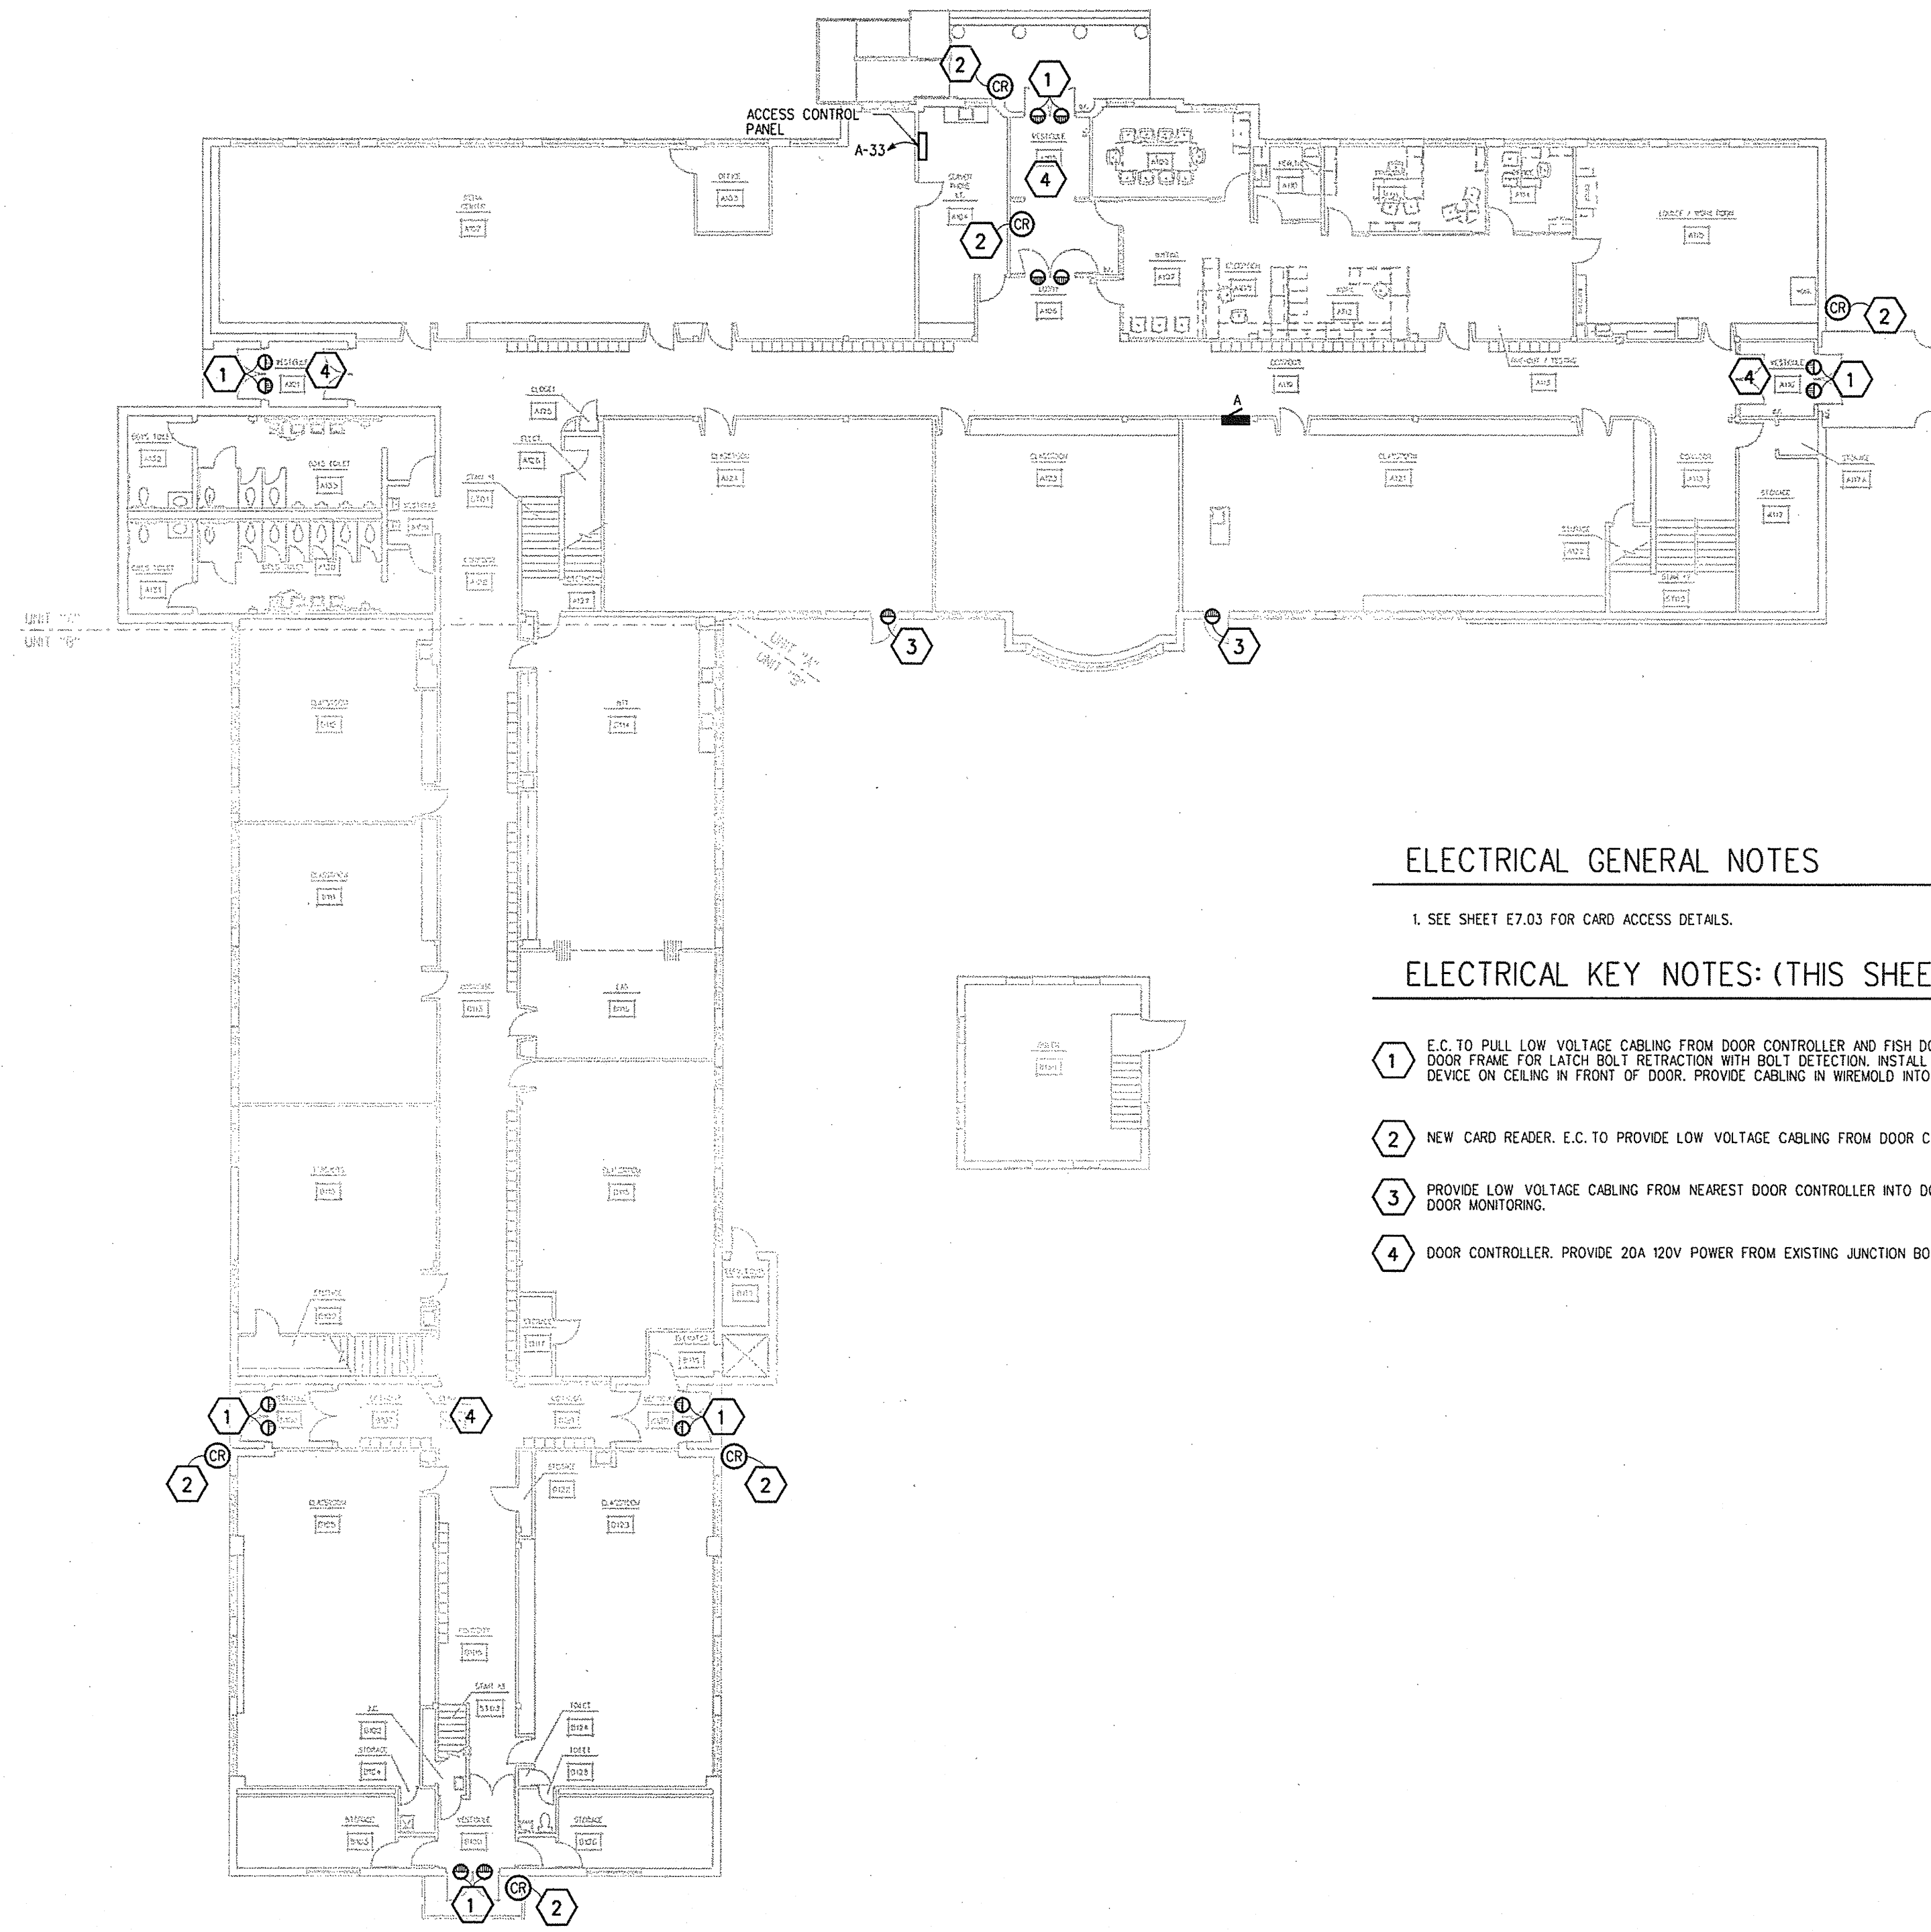


ELECTRICAL GENERAL NOTES

1. SEE SHEET E7.03 FOR CARD ACCESS DETAILS.

ELECTRICAL KEY NOTES: (THIS SHEET ONLY)

- 1. E.C. TO PULL LOW VOLTAGE CABLING FROM DOOR CONTROLLER AND FISH DOWN MILLION OR DOOR FRAME FOR LATCH BOLT RETRACTION WITH BOLT DETECTION. INSTALL REQUEST TO EXIT DEVICE ON CEILING IN FRONT OF DOOR. PROVIDE CABLING IN WHELMOLD INTO DOOR FRAME.
- 2. NEW CARD READER. E.C. TO PROVIDE LOW VOLTAGE CABLING FROM DOOR CONTROLLER.
- 3. PROVIDE LOW VOLTAGE CABLING FROM NEAREST DOOR CONTROLLER INTO DOOR FRAME FOR DOOR MONITORING.
- 4. DOOR CONTROLLER. PROVIDE 20A 120V POWER FROM EXISTING JUNCTION BOX ABOVE CEILING.

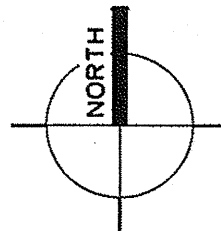

PINE STREET ELEMENTARY OVERALL ELECTRICAL PLAN  
Scale: 1/16" = 1'