


KITCHEN ELECTRICAL GENERAL NOTES

- E.C. SHALL REVIEW FOOD SERVICE DRAWINGS (E.C. SEERIES) AND FOOD SERVICE SPECIFICATIONS SECTION 11-400 FOR ADDITIONAL SCOPE OF WORK AND REQUIREMENTS. INCLUDE ALL WORK AND MATERIALS AS ASSIGNED TO THE E.C. BY DRAWINGS, SPECIFICATIONS, WORK CATEGORY ASSIGNMENTS, ETC.
- IF THERE IS A CONFLICT BETWEEN THE FOOD SERVICE DRAWINGS/SPECIFICATIONS AND THIS DRAWING OR DIVISION 16 SPECIFICATIONS, THE E.C. SHALL BID THE GREATEST-COST OPTION OR MORE STRINGENT REQUIREMENT. CLARIFICATIONS MAY BE REQUESTED IN WRITING PRIOR TO BID - COORDINATE WITH CONSTRUCTION MANAGER.
- THE WORK SHOWN ON THIS DRAWING AND THE DIVISION 16 SPECIFICATIONS SHALL SUPERSEDE THE FOOD SERVICE DRAWINGS/SPECIFICATIONS.
- ALL 20A 120V RECEPTACLES IN THE KITCHEN AND SERVERY AREA ARE TO BE GFCI-PROTECTED.

KEYED NOTES (THIS SHEET ONLY)

- 01 EXHAUST HOOD FIRE SUPPRESSION SYSTEM, INTERCONNECT WITH FIRE ALARM INITIATION CIRCUIT FOR MONITORING PER LOCAL CODES.
- 02 CONTACTOR FOR SHUTDOWN OF ELECTRICAL SYSTEMS UNDER EXHAUST HOOD LOCATED ABOVE CEILING, INTERLOCK WITH HOOD FIRE SUPPRESSION SYSTEM, SMOKE RESET SWITCH, AND BRANCH CIRCUIT LOADS UNDER HOOD AS SHOWN ON DETAIL DWG/EL.
- 03 GROUND-FAULT PROTECTION PROVIDED BY GFCI/CIRCUIT BREAKER IN PANEL/SUBPANEL - SEE PANEL SCHEDULE.
- 04 STUB 3/4" CONDUIT INTO JUNCTION BOX LOCATED ON FOOD SERVICE EQUIPMENT. PULL ALL CIRCUITS FOR ADJACENT EQUIPMENT THROUGH JUNCTION BOX.
- 05 E.C. TO PROVIDE TIE-IN SWITCH TO FOOD SERVICE EQUIPMENT INSTALLER FOR INSTALLATION IN WALK-IN UNIT (REPLACE STANDARD SWITCH IF INSTALLED AT FACTORY). SET TIMEOUT PERIOD FOR 4 HOURS.
- 06 E.C. SHALL INTERWIRE ALL COMPONENTS OF WALK-IN COOLER OR FREEZER AS SHOWN ON DRAWINGS AND REQUIRED BY EQUIPMENT MANUFACTURER. COORDINATE WITH SHOP DRAWINGS.
- 07 E.C. SHALL INTERWIRE ALL COMPONENTS OF MAKE-UP AIR UNIT, EXHAUST FAN, HOOD LIGHTS, AND HOOD CONTROLS AS SHOWN ON DRAWINGS AND REQUIRED BY EQUIPMENT MANUFACTURER. COORDINATE WITH SHOP DRAWINGS. NOTE THAT EXHAUST FAN WILL REQUIRE SEPARATE WIRING FROM ROOFTOP CONTROLS.
- 08 GFCI-PROTECTED CORD DROP RECEPTACLE WITH STRAIN PROTECTION.
- 09 GFCI-PROTECTED RECEPTACLE MOUNTED AT 5' AFF. ON CONDUIT STUBBED FROM FLOOR.

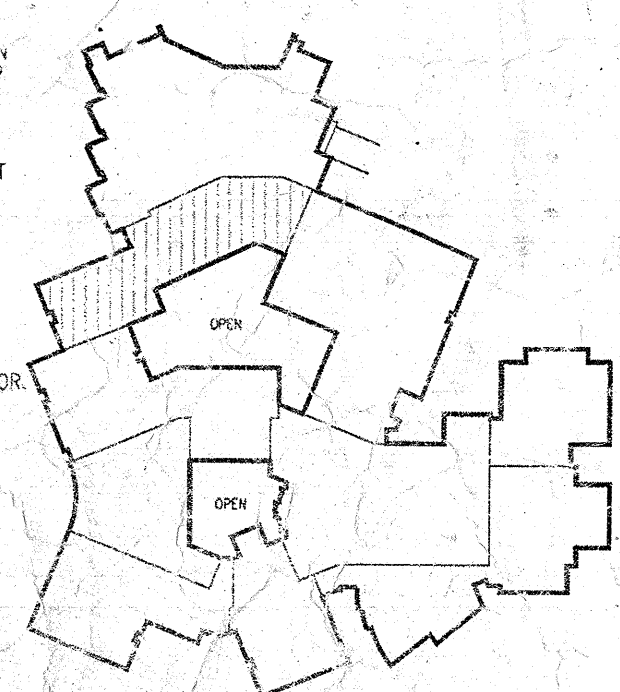

ENLARGED KITCHEN POWER PLAN