

DATES OF ISSUE

NO.	DATE	DESCRIPTION
1	5-7-09	GC REVIEW
2	6-12-09	OWNER REVIEW
3	6-24-09	BIDS AND CONSTRUCTION
4		
5		
6		
7		
8		
9		
10		

Copyright 2009 Acoustics By Design, Inc. All information on this drawing is the exclusive property of Acoustics By Design, Inc. and is furnished for use on the above project only. No part of this drawing may be duplicated without written consent from Acoustics By Design, Inc.

WAYLAND HIGH SCHOOL

HIGH SCHOOL ADDITIONS AND REMODELING


WAYLAND, MICHIGAN

Designed by:
TGH, SS
Drawn by:
DWB
Checked by:
TGH, SS
Date Drawn:
05-01-2009
Sheet Title

**AUDIO SECONDARY
SCHEMATIC
AUDITORIUM**

Sheet No. 3 of 16
Drawing Scale: NONE

AV102

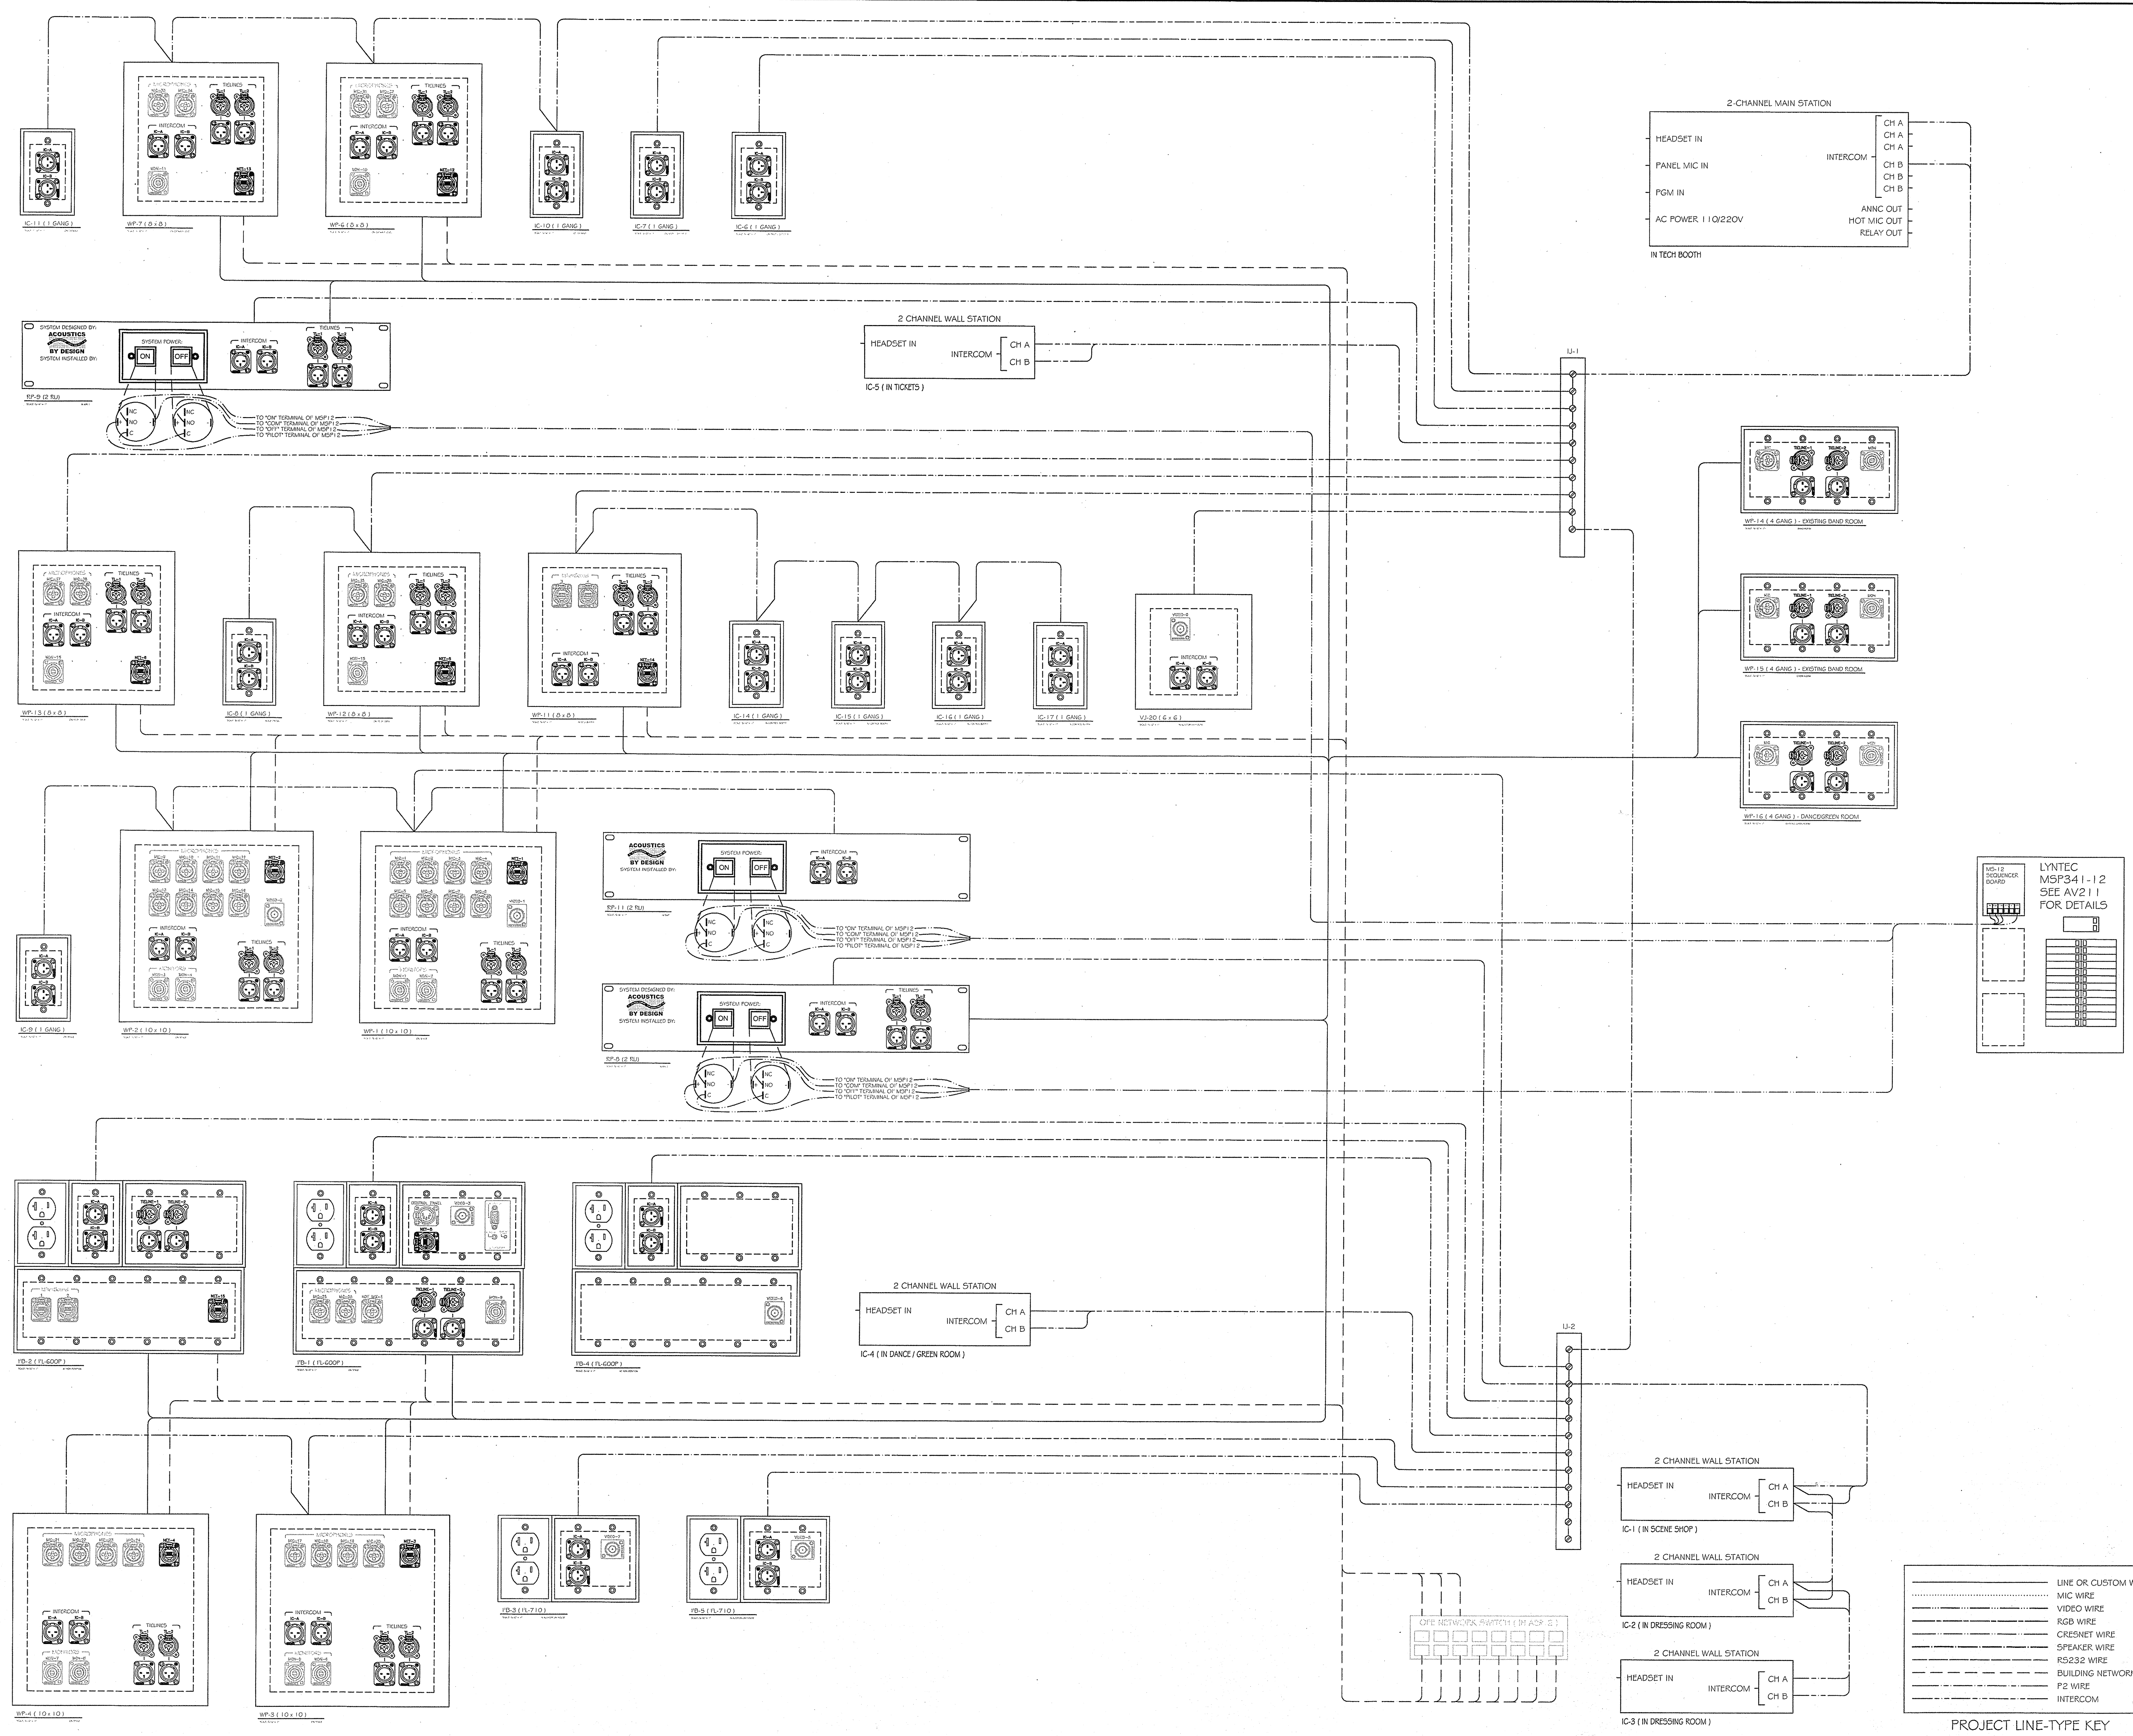

LYNTEC
MSP341-12
SEE AV211
FOR DETAILS

PROJECT LINE-TYPE KEY

LINE OR CUSTOM WIRE
MIC WIRE
VIDEO WIRE
RGB WIRE
CENET WIRE
SPEAKER WIRE
RS232 WIRE
BUILDING NETWORK
P2 WIRE
INTERCOM