
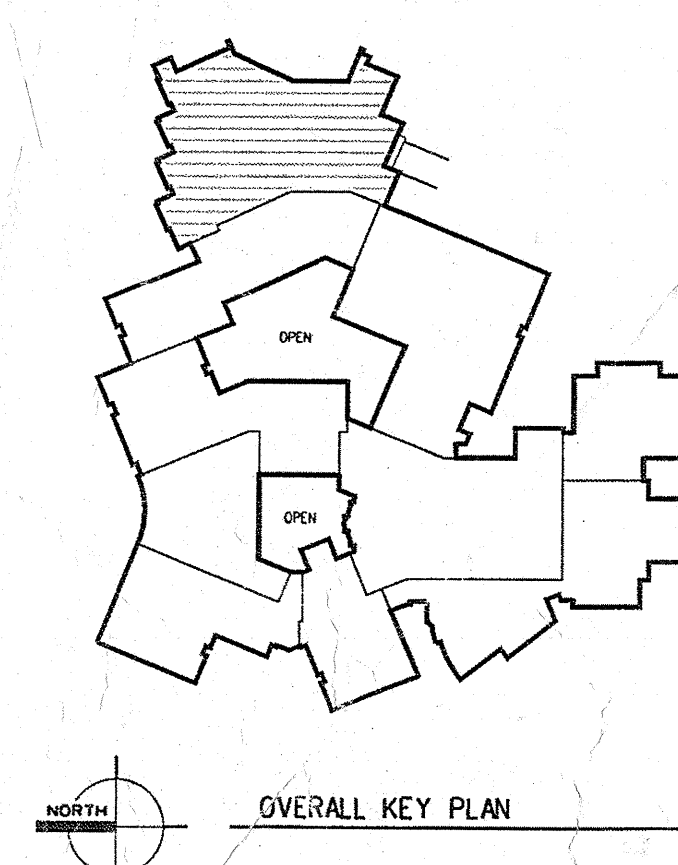


Amendment No. 2  
Refer to Storage B203 - Add Bylin High Efficiency Control System (HECS) panel on north wall adjacent to LCP-11 for roof and gutter de-icing. Circuit to 50A 2-pole breaker in Panel BP-Q. See specification section 16.780 for more information.

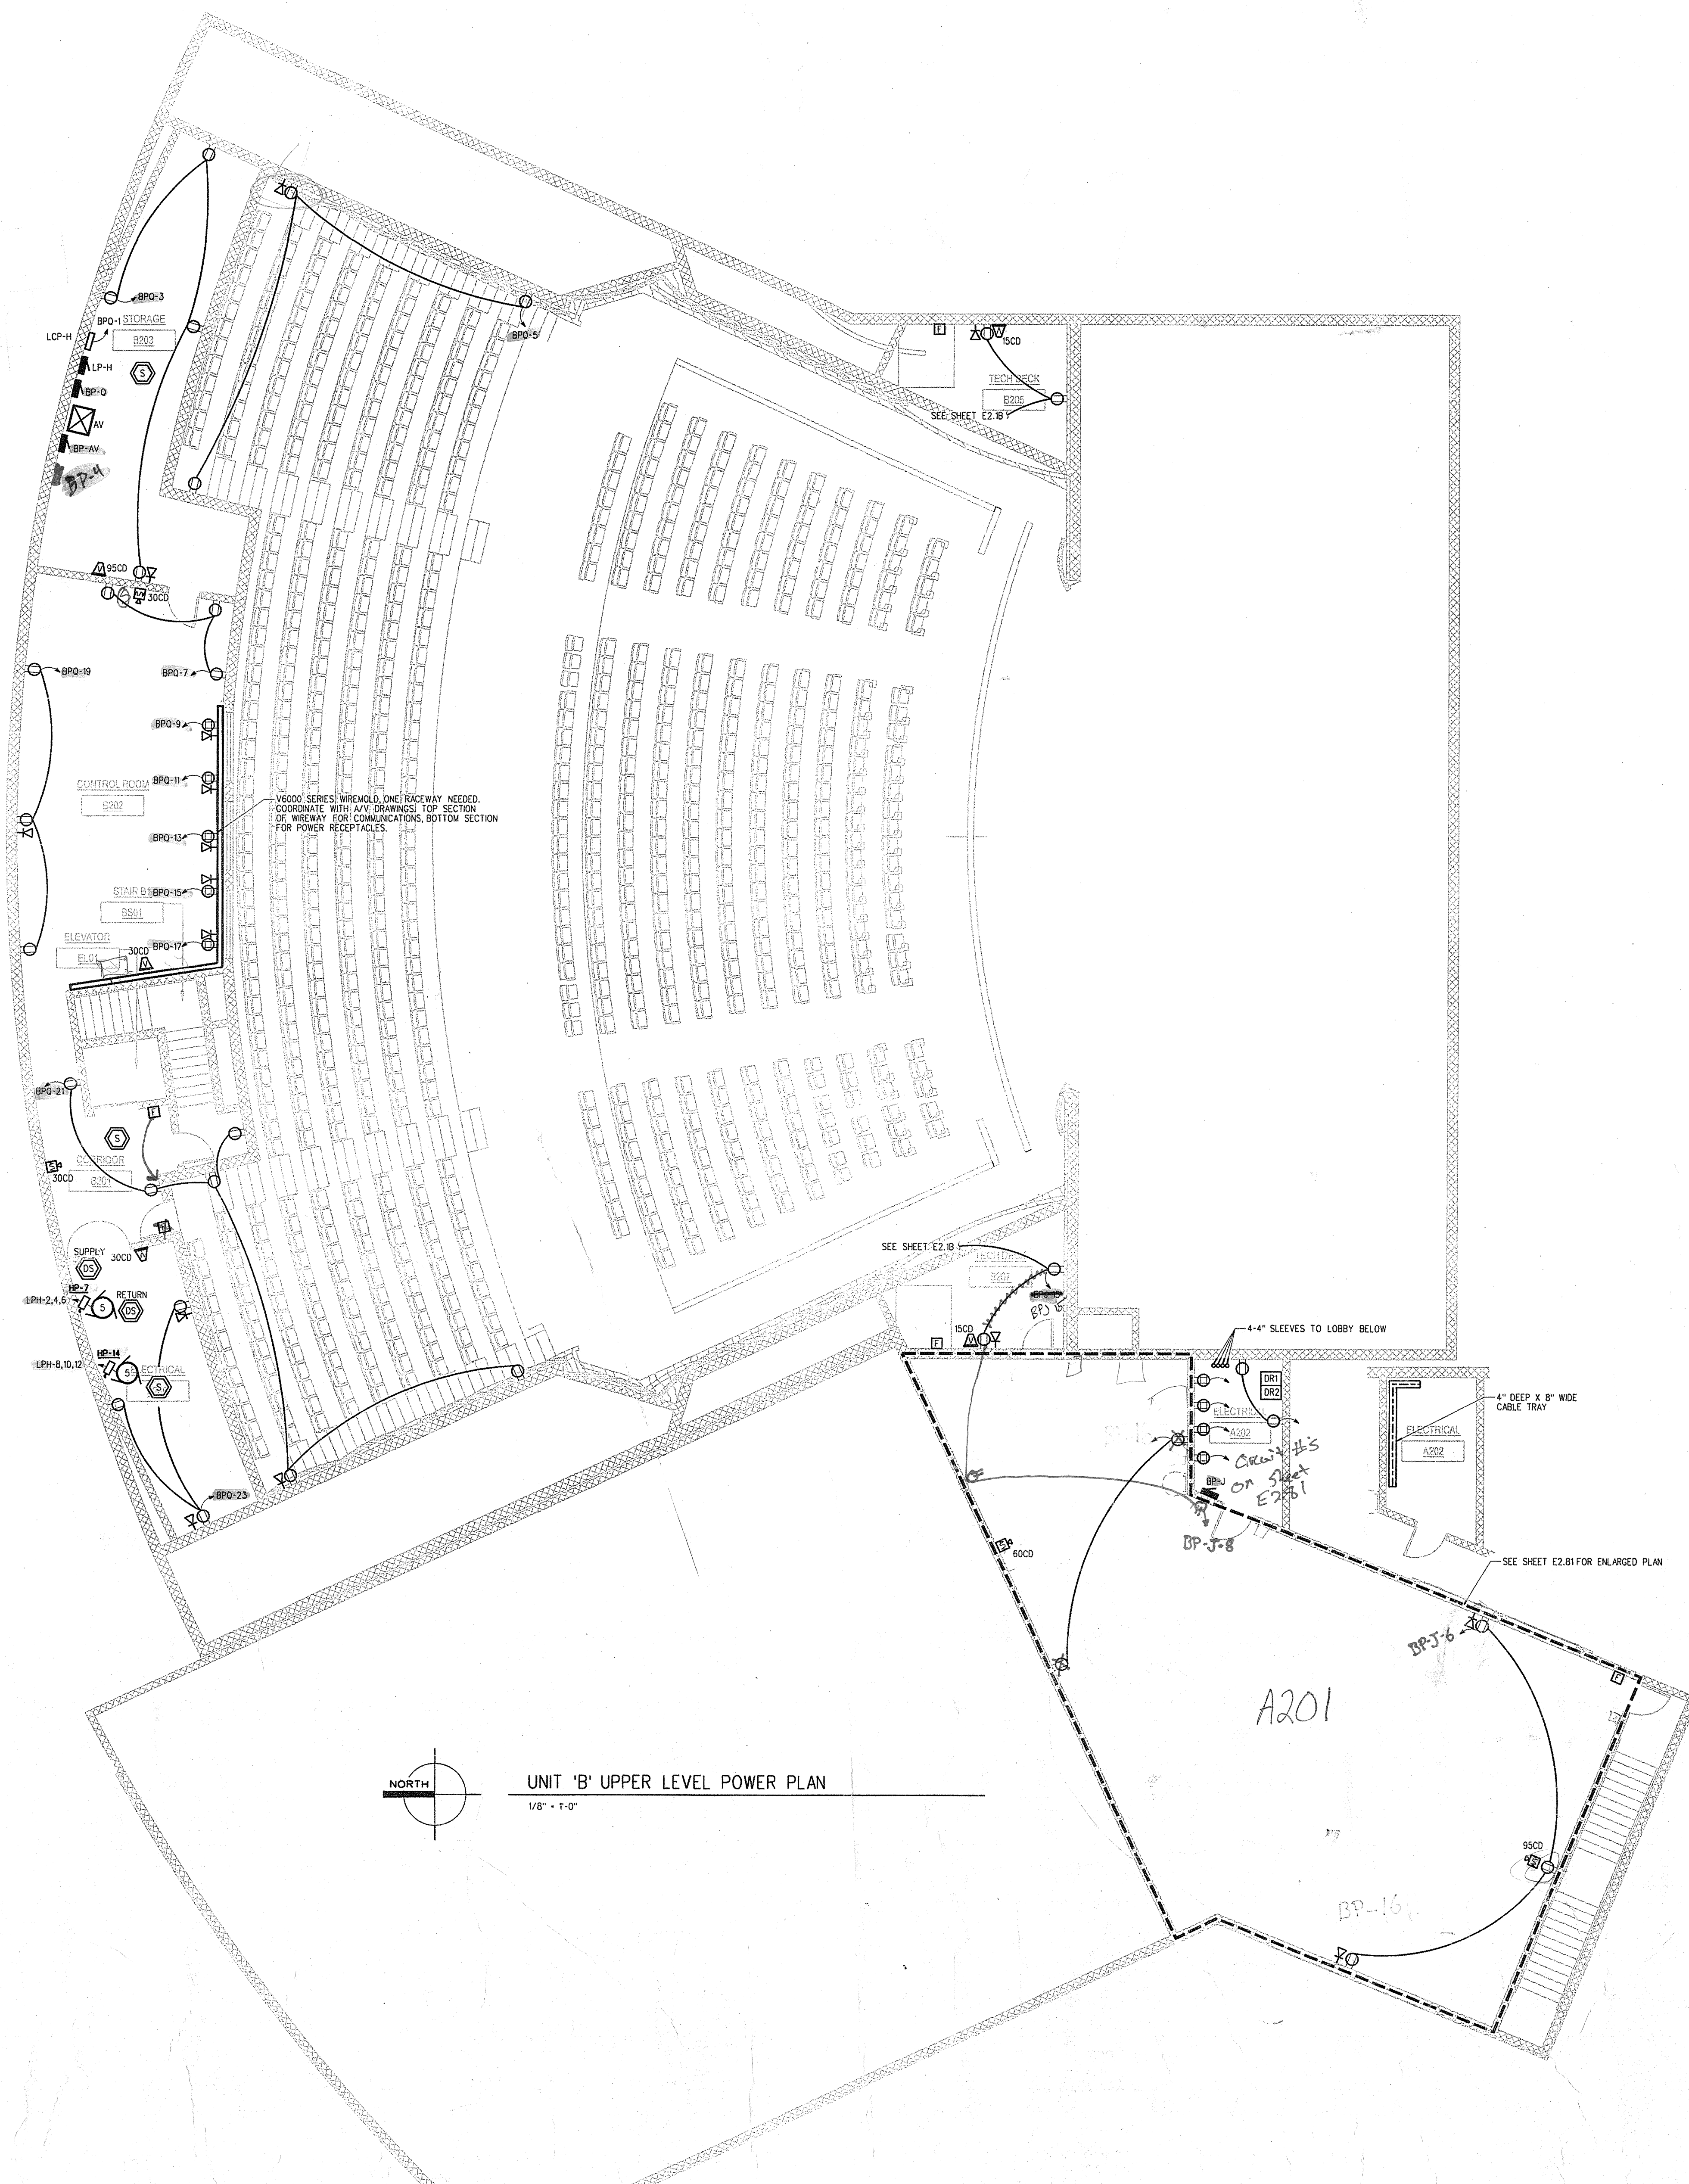


FINE ARTS CENTER ADDITION  
**WAYLAND UNION SCHOOLS**  
WAYLAND, MICHIGAN

PROJECT NO. 5-1282  
Copyright © 2009  
CMB Architects + Engineers  
All Rights Reserved

UNIT 'B'  
UPPER LEVEL  
POWER PLAN

**E2.2B**

REVISIONS	DATE	BY	CHK

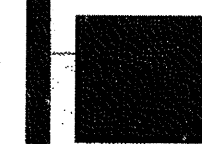

CMB Architects + Engineers  
86 East Eighth Street, Suite 200  
Wayland, MI 48384

No part of this drawing may be reproduced in any form or by any means, stored in a database or retrieval system, without written permission of CMB Architects + Engineers.

6/25/2009 10:00:00 AM  
PLOT DATE / TIME 6/25/2009 8:48:27 AM