
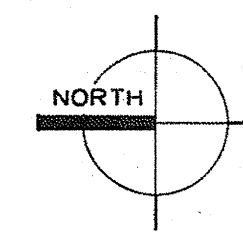


No part of this drawing may be reproduced in any form or by any means, except in a database or retrieval system, without written permission of GMB Architecture + Engineering.

2/13/2009 5:18:32 PM
PLOT DATE / TIME: 6/25/2009 6:48:09 AM
scottg

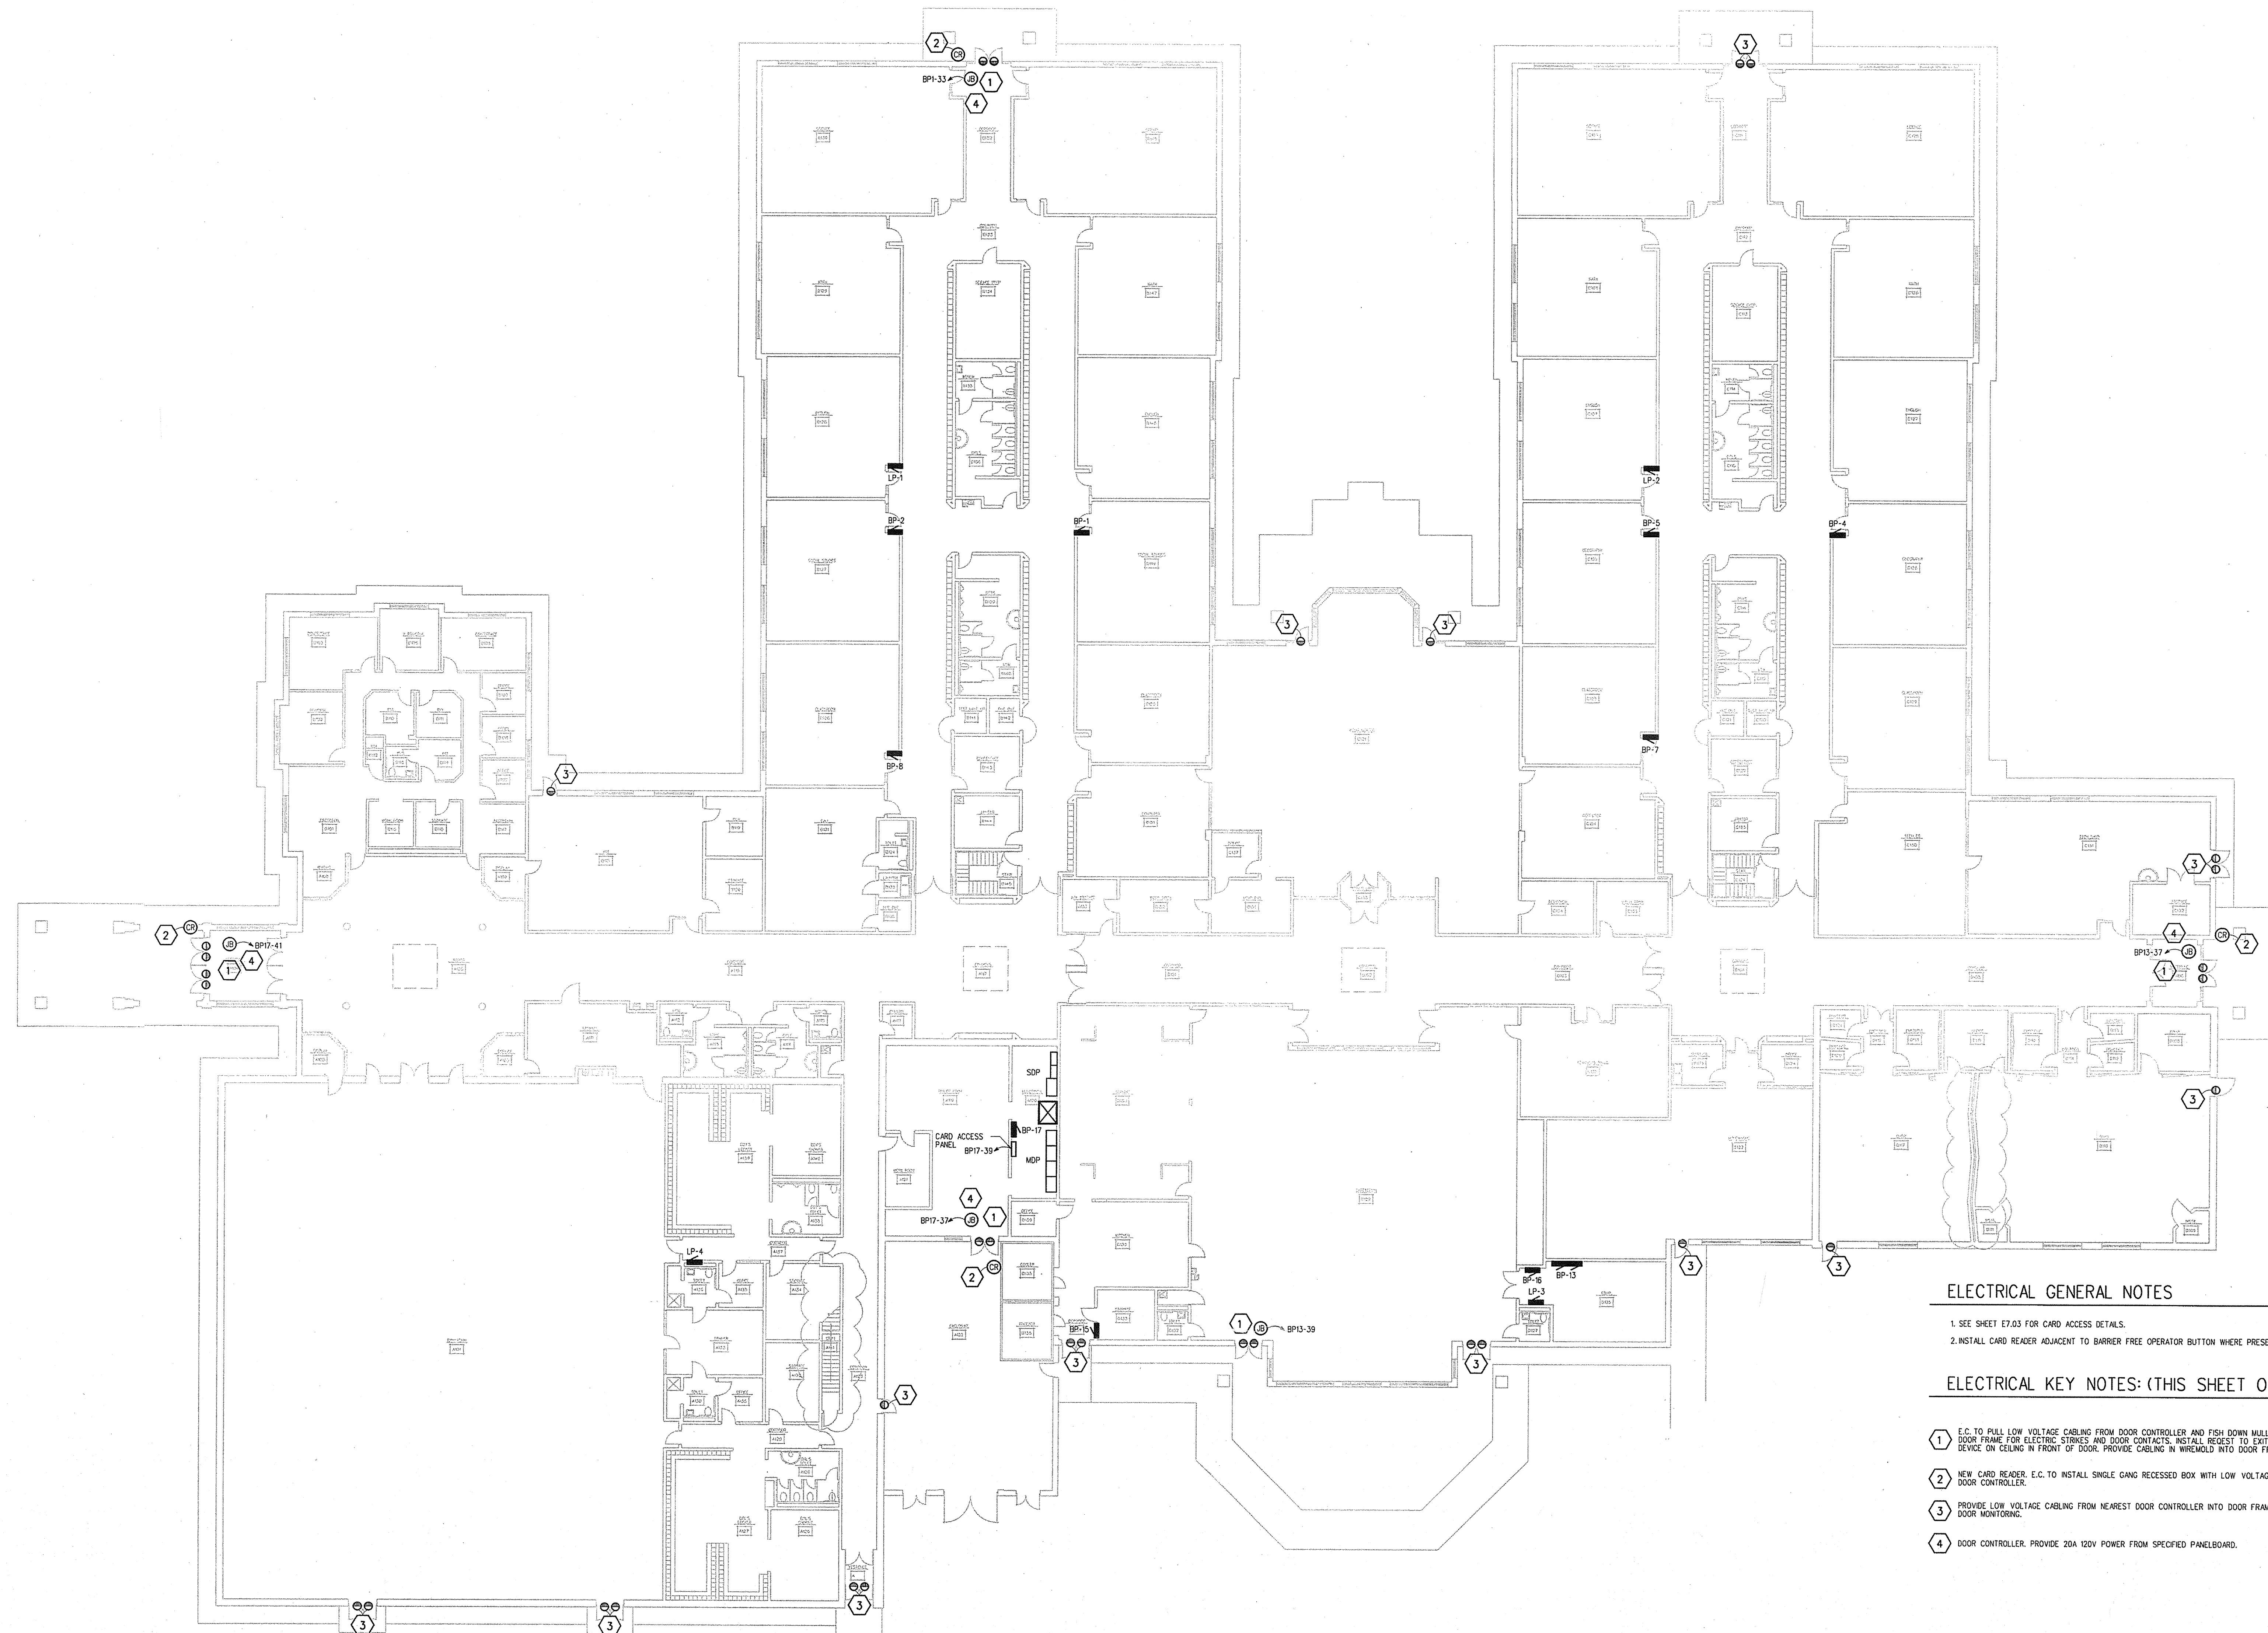

MIDDLE SCHOOL OVERALL ELECTRICAL PLAN
Scale: 1/8" = 1'

ELECTRICAL GENERAL NOTES

- SEE SHEET E7.03 FOR CARD ACCESS DETAILS.
- INSTALL CARD READER ADJACENT TO BARRIER FREE OPERATOR BUTTON WHERE PRESENT. FIELD VERIFY.

ELECTRICAL KEY NOTES: (THIS SHEET ONLY)

- E.C. TO PULL LOW VOLTAGE CABLING FROM DOOR CONTROLLER AND FISH DOWN WALL/ON OR DOOR FRAME FOR ELECTRIC STRIKES AND DOOR CONTACTS. INSTALL RECESS TO EXIT DEVICE ON CEILING IN FRONT OF DOOR. PROVIDE CABLING IN WIREMOLD INTO DOOR FRAME.
- NEW CARD READER. E.C. TO INSTALL SINGLE GANG RECESSED BOX WITH LOW VOLTAGE CABLING FROM DOOR CONTROLLER.
- PROVIDE LOW VOLTAGE CABLING FROM NEAREST DOOR CONTROLLER INTO DOOR FRAME FOR DOOR MONITORING.
- DOOR CONTROLLER. PROVIDE 20A 120V POWER FROM SPECIFIED PANELBOARD.

REVISIONS	DATE	BY	APP'D