

WAYLAND HIGH SCHOOL

HIGH SCHOOL ADDITIONS AND REMODELING

WAYLAND, MICHIGAN

Designed by
TGH, SS

Drawn by
DWB

Date Drawn:
04-16-2000

Checked By:
TGH, SS


Sheet Title

AUDIO / VIDEO
AUDITORIUM CONDUIT
AND BOX LOCATIONS
CATWALK LEVEL PLAN

Sheet No. 7 of 16

Drawing Scale: 1/8" = 1'-0"

AV203

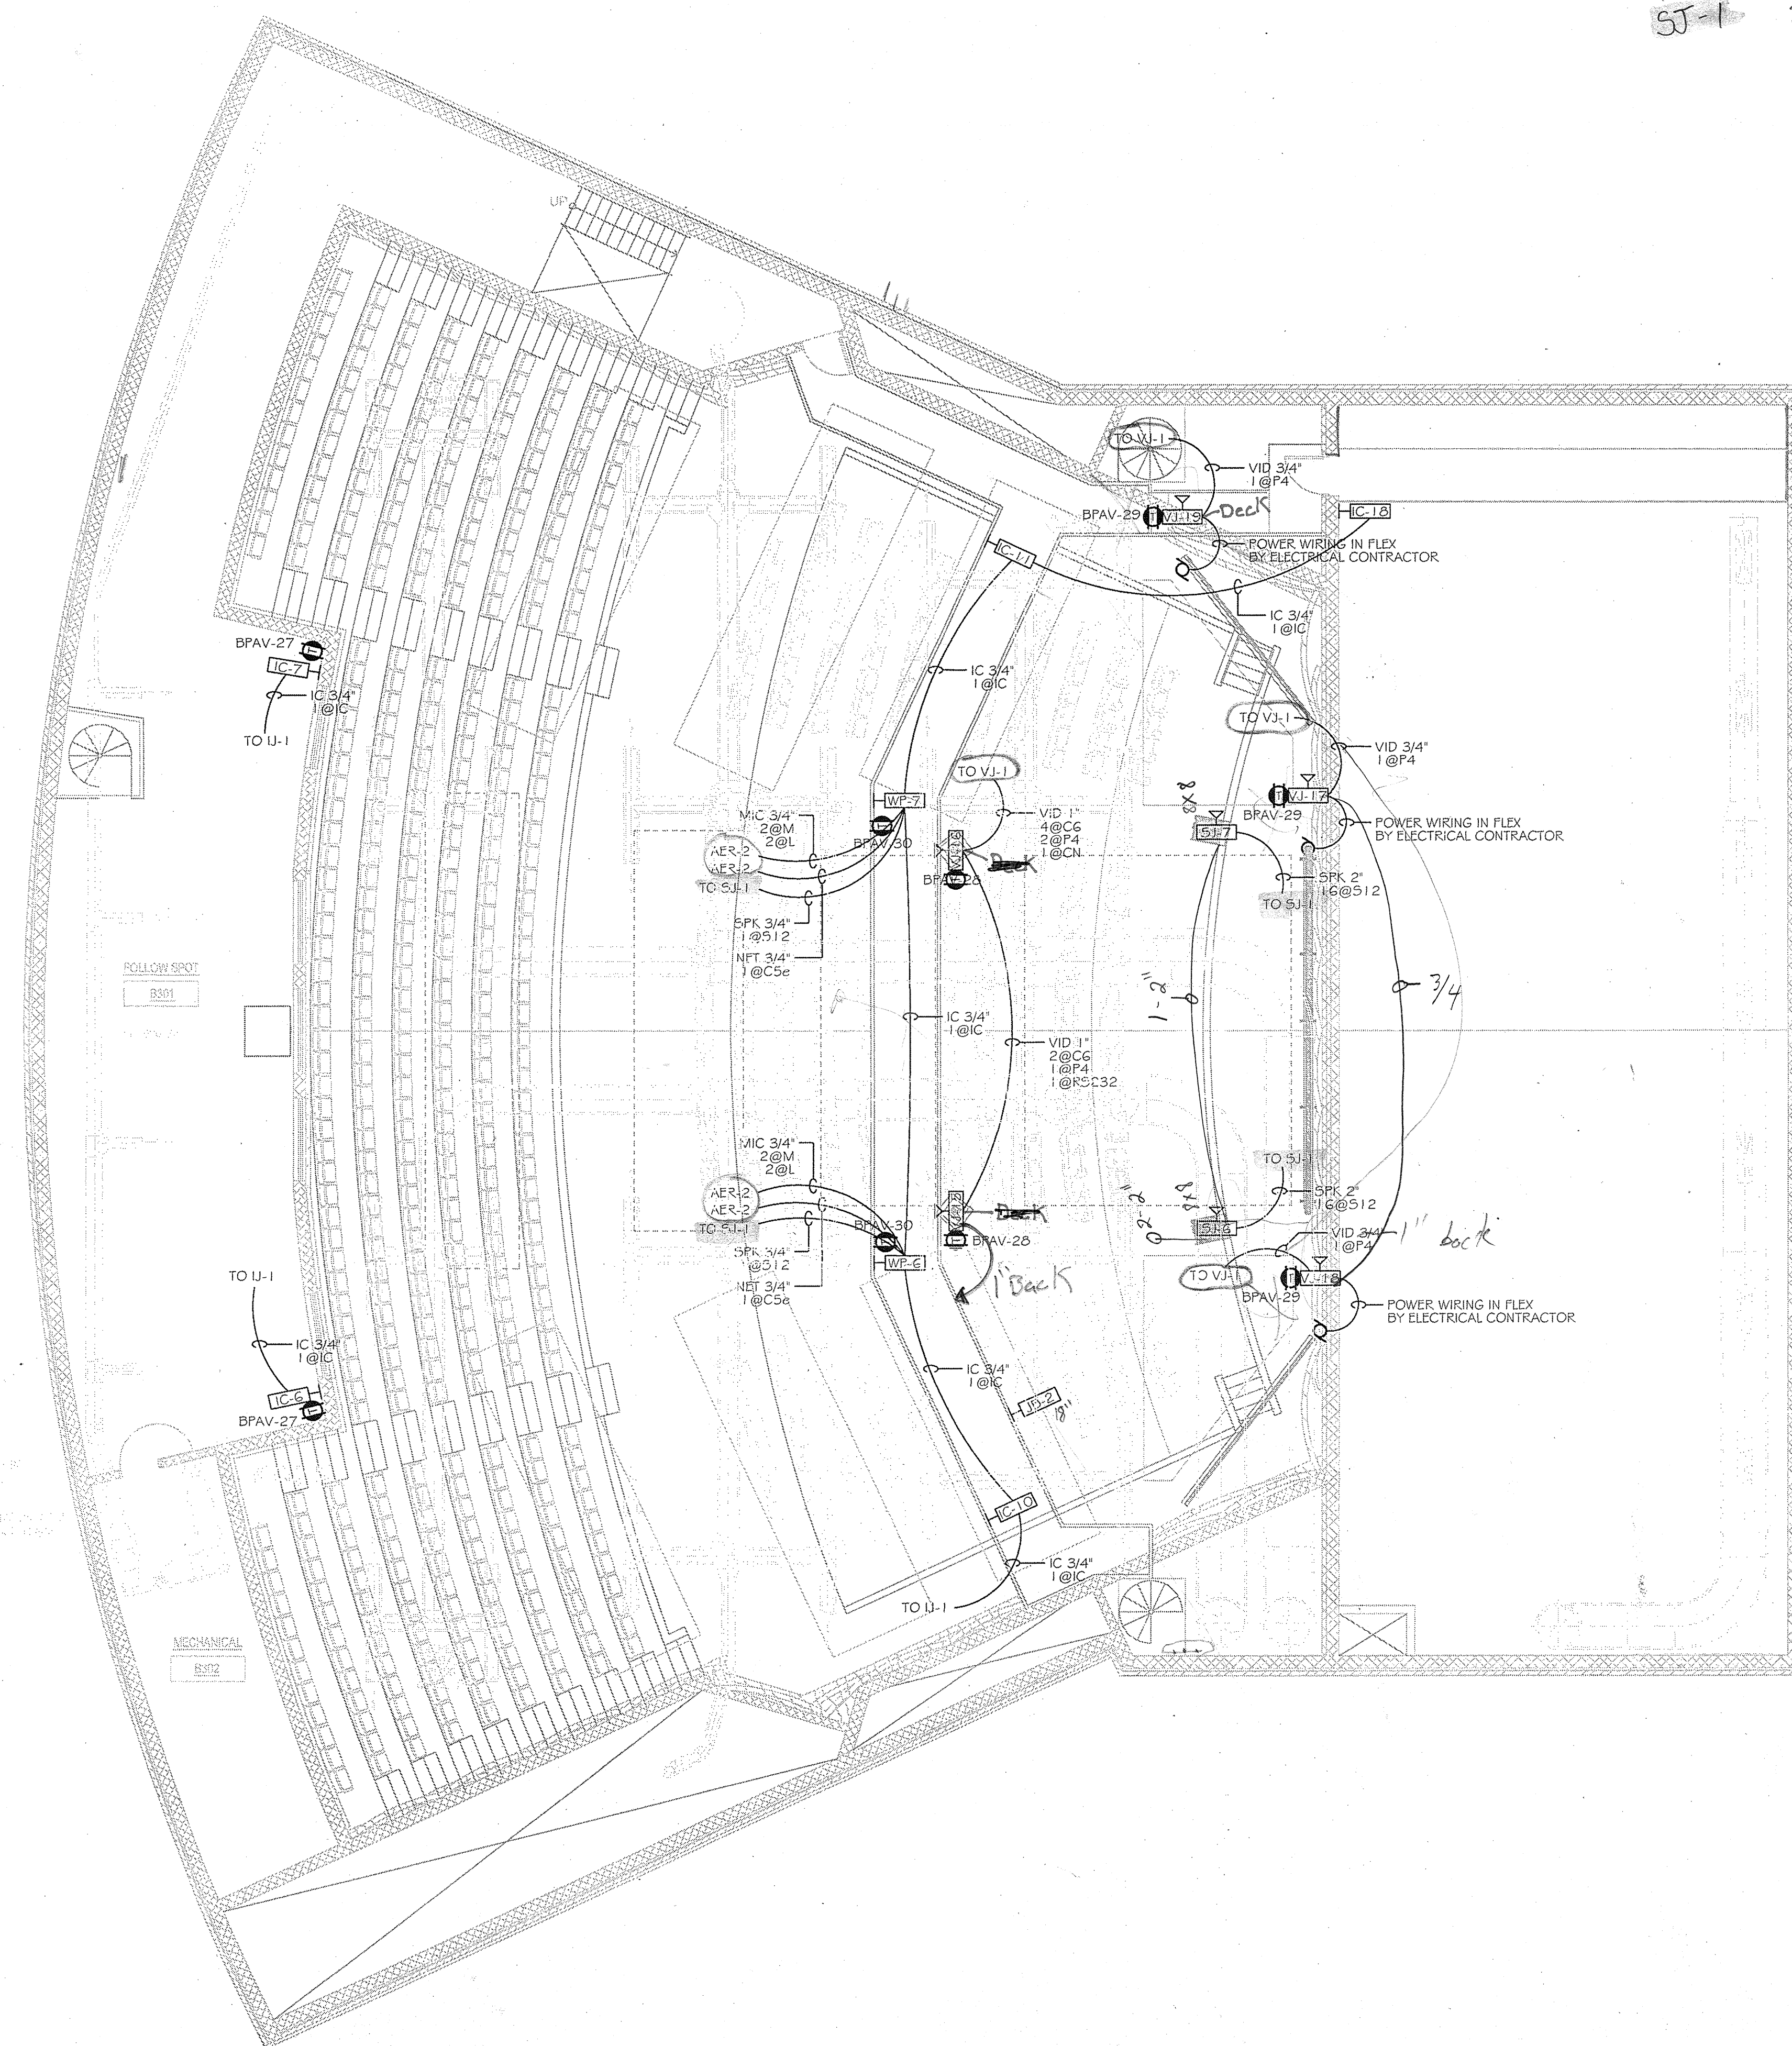

VJ-1 2nd
1J-1 2nd
AER-2 1st
BPAU 2nd
SJ-1 2nd

1" KO fill
3/4" washers

