


DATES OF ISSUE	
NO.	DATE • DESCRIPTION
1	5-7-09 • GC REVIEW
2	6-12-09 • OWNER REVIEW
3	6-24-09 • BIDS AND CONSTRUCTION

Copyright 2009 Acoustics By Design, Inc. All information on this drawing is the exclusive property of Acoustics By Design, Inc. and is furnished for use on the above project only. No part of this drawing may be duplicated without written consent from Acoustics By Design, Inc.

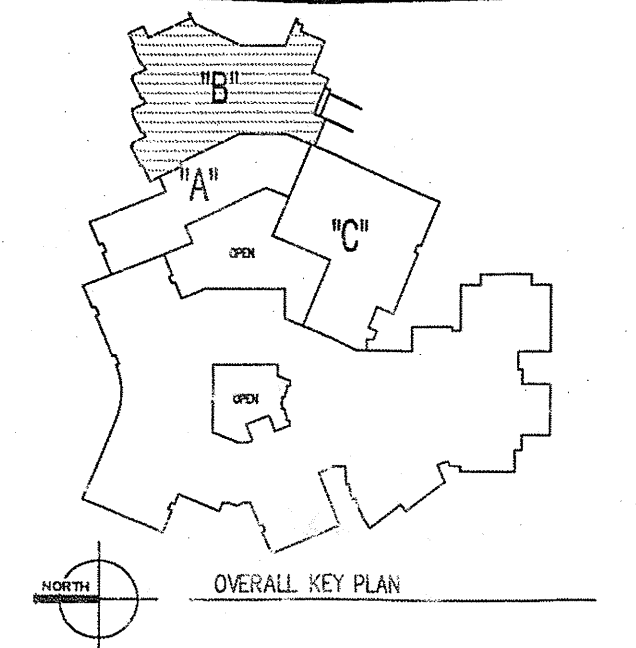

# WAYLAND HIGH SCHOOL

## HIGH SCHOOL ADDITIONS AND REMODELING

### WAYLAND, MICHIGAN

Designed by: TGH, SS

Drawn by: DWB Date Drawn: 04-16-2009

Checked By: TGH, SS

Sheet Title

AUDIO / VIDEO  
AUDITORIUM CONDUIT  
AND BOX LOCATIONS  
FLOOR PLAN

Sheet No. 5 of 16  
Drawing Scale:  $1/8" = 1'-0"$

AV201

