




1 JUNCTION BOX INSTALLATION DETAIL
NO SCALE

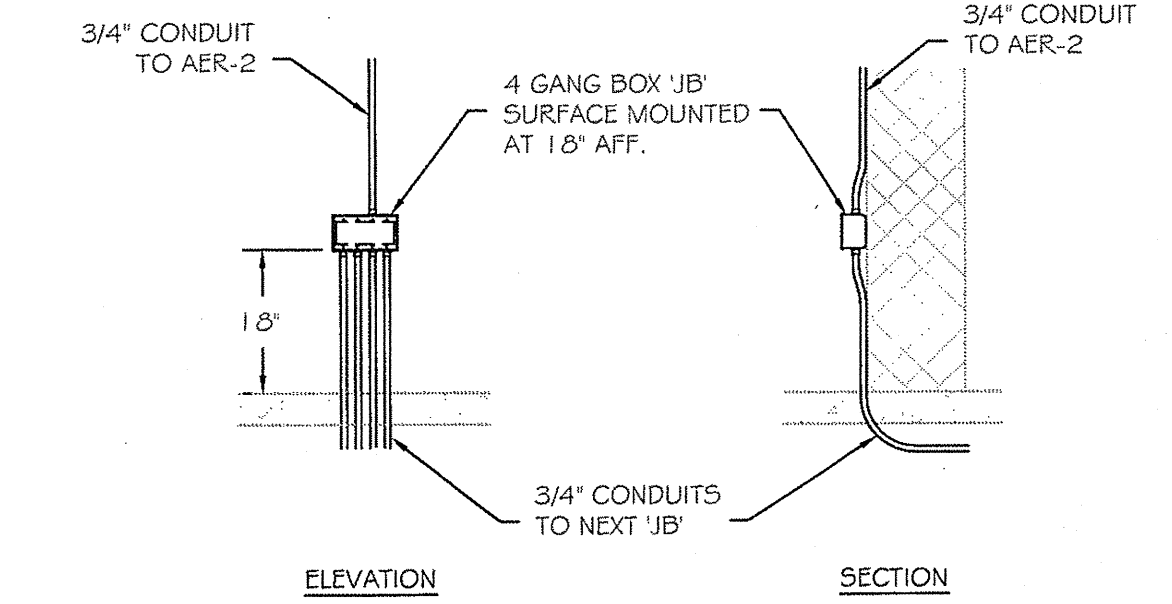

2 JUNCTION BOX INSTALLATION DETAIL
NO SCALE

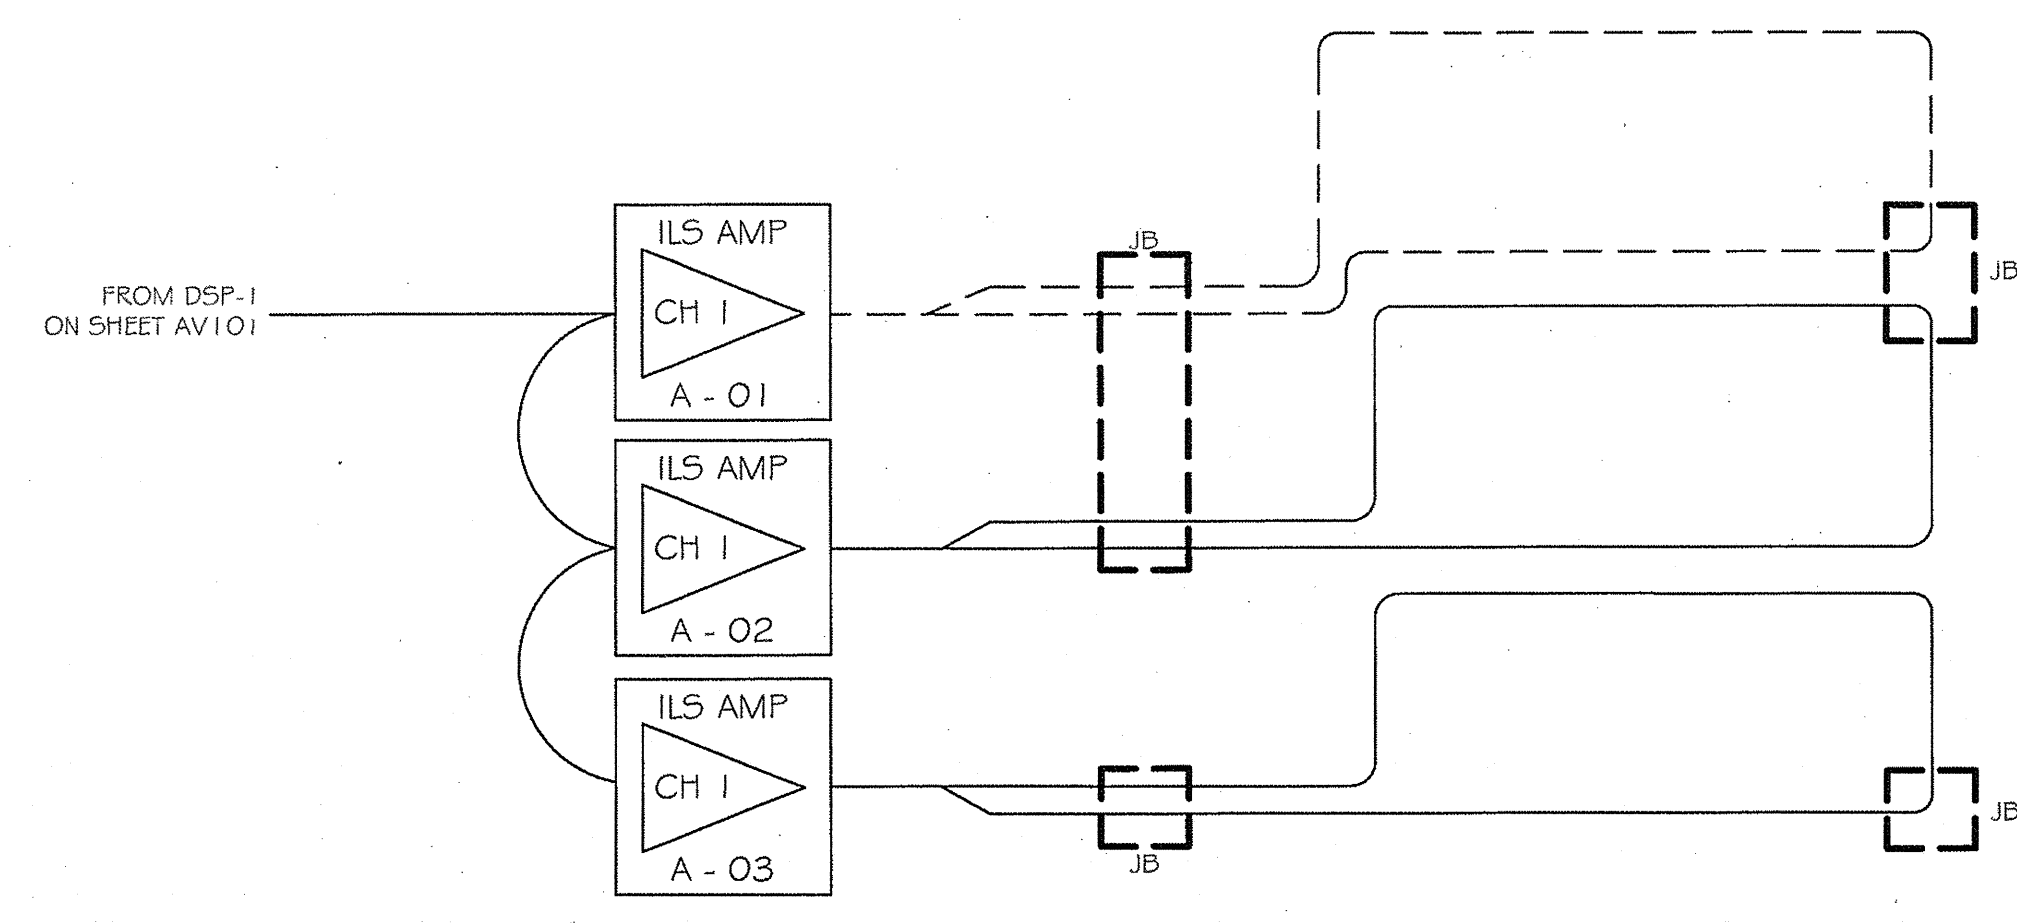

3 INDUCTIVE LOOP SCHEMATIC
NO SCALE

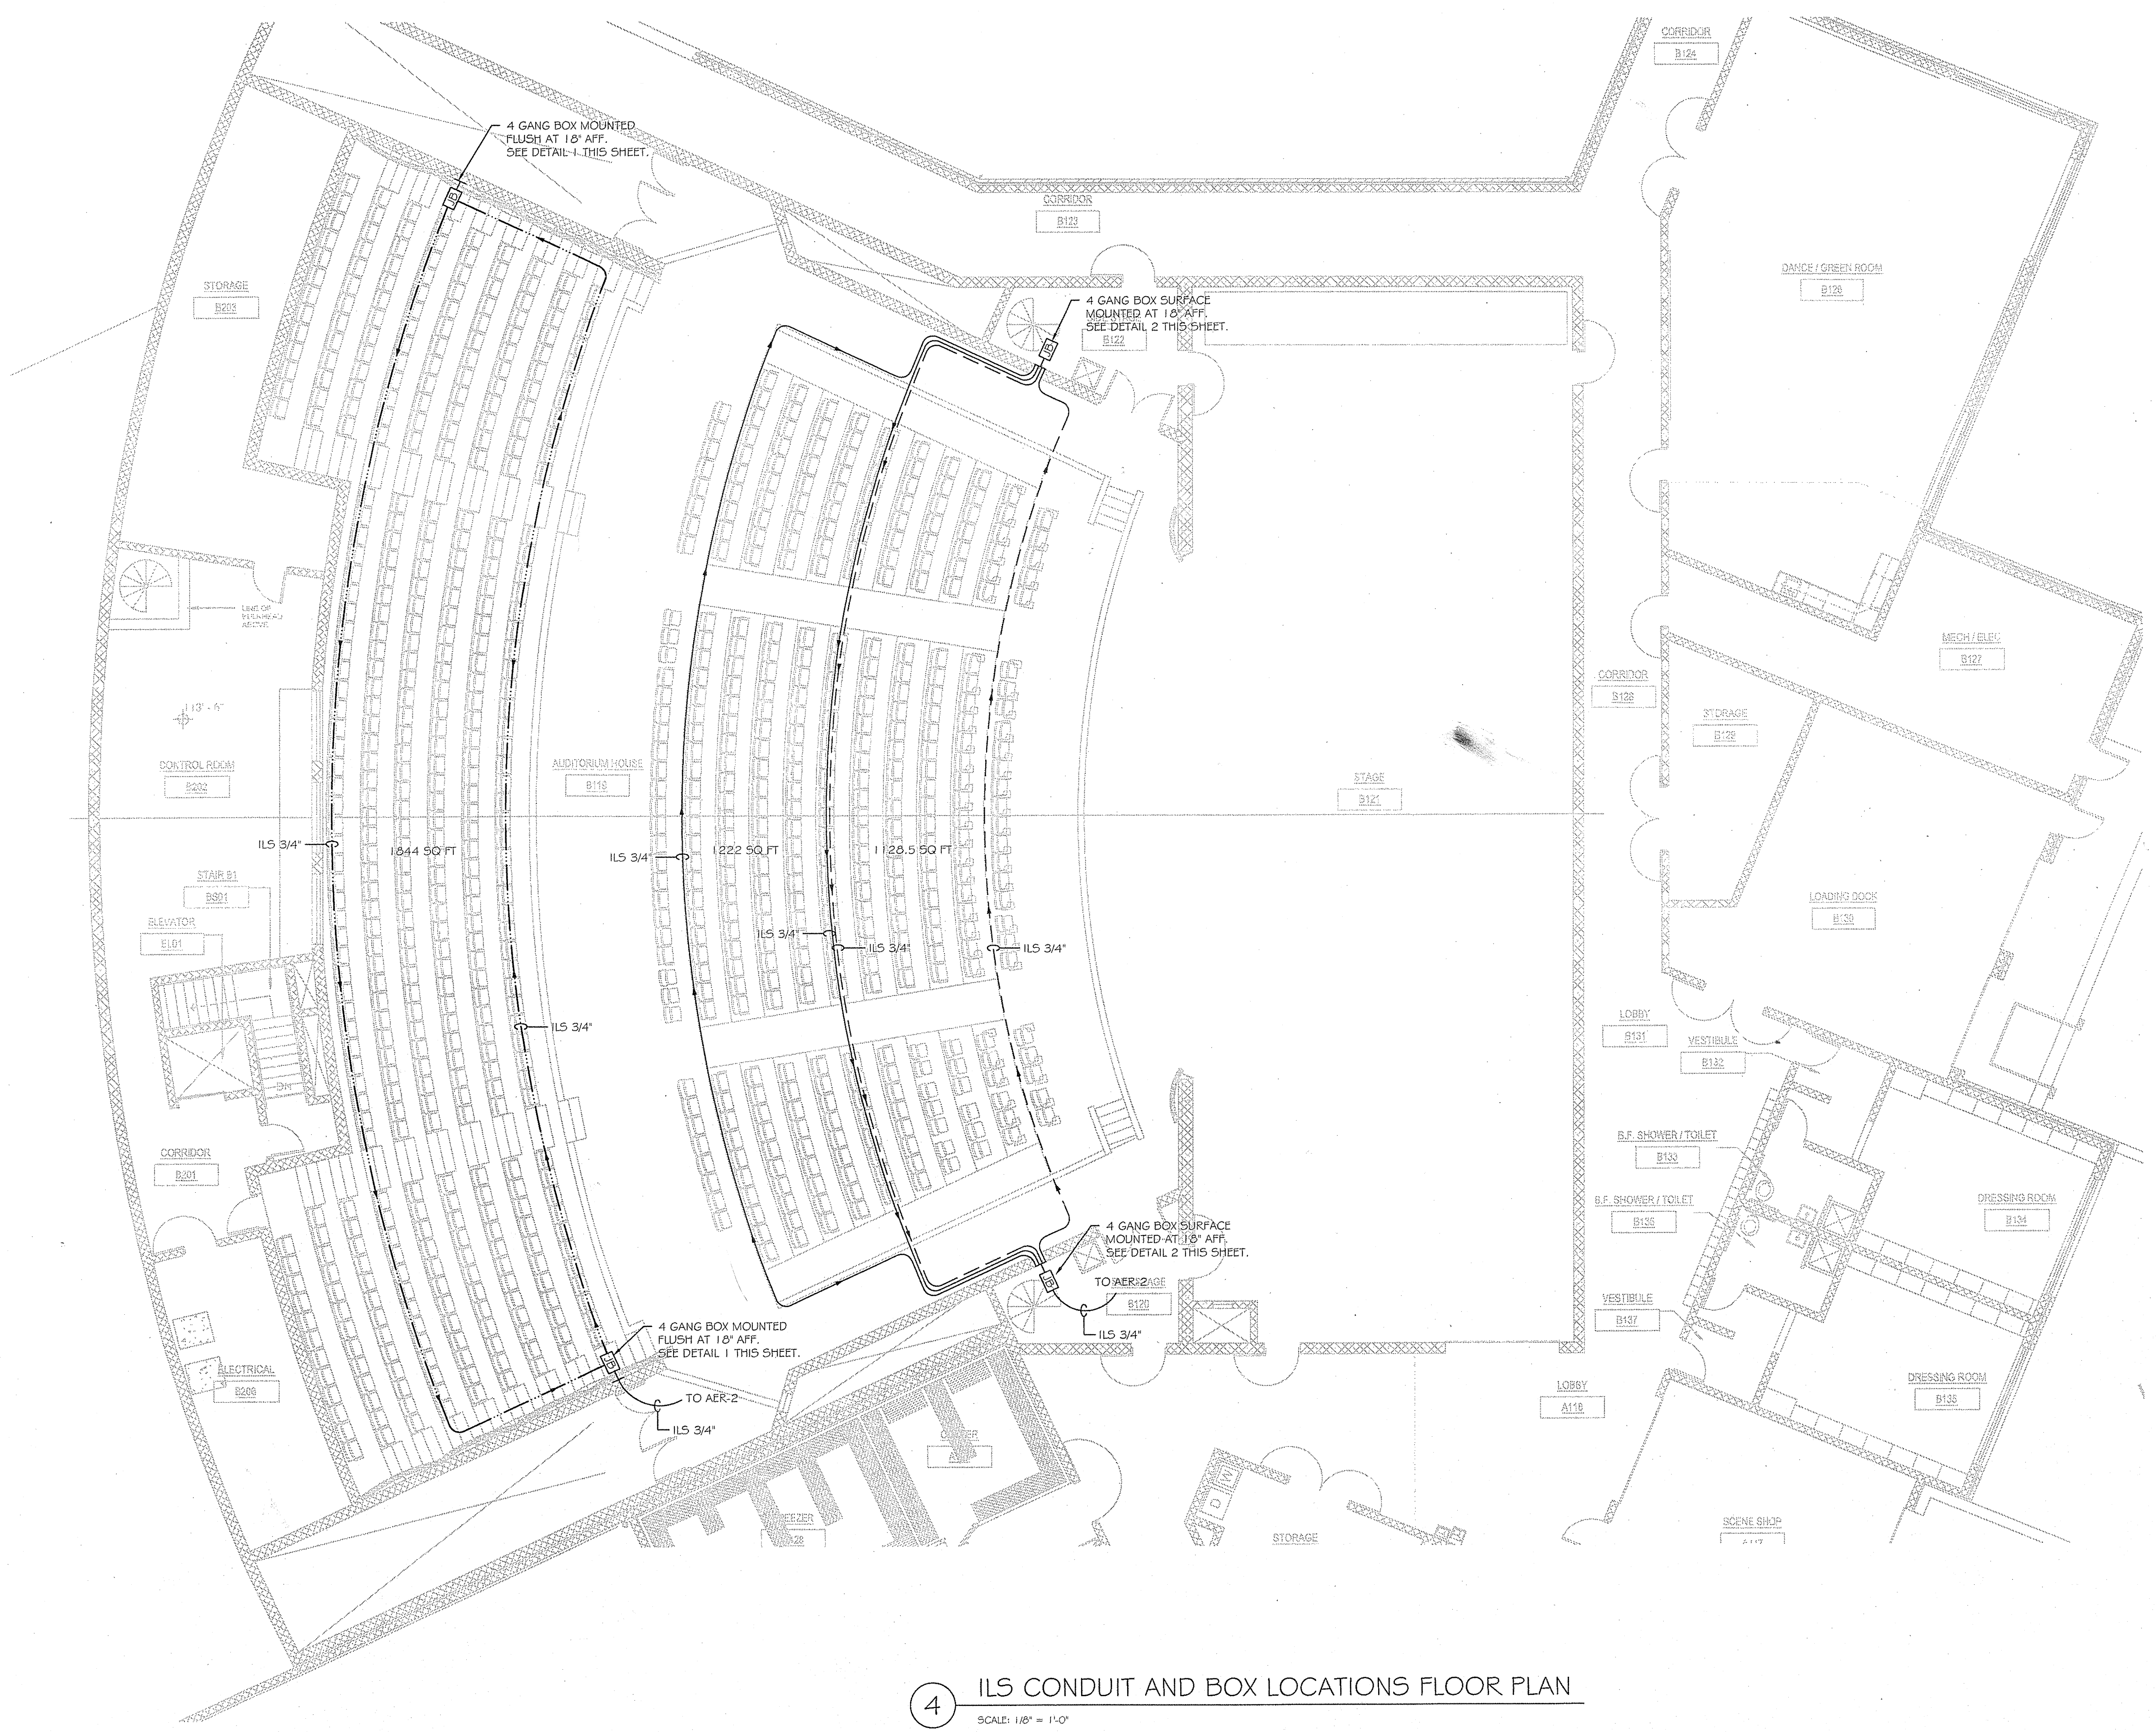


4 ILS CONDUIT AND BOX LOCATIONS FLOOR PLAN
SCALE: 1/8" = 1'-0"

BY

NO.	DATE	DESCRIPTION
1	06-24-09	BIDS AND CONSTRUCTION

Copyright 2009 Acoustics By Design, Inc. All information on this drawing is the exclusive property of Acoustics By Design, Inc. and is furnished for use on the above project only. No part of this drawing may be duplicated without written consent from Acoustics By Design, Inc.

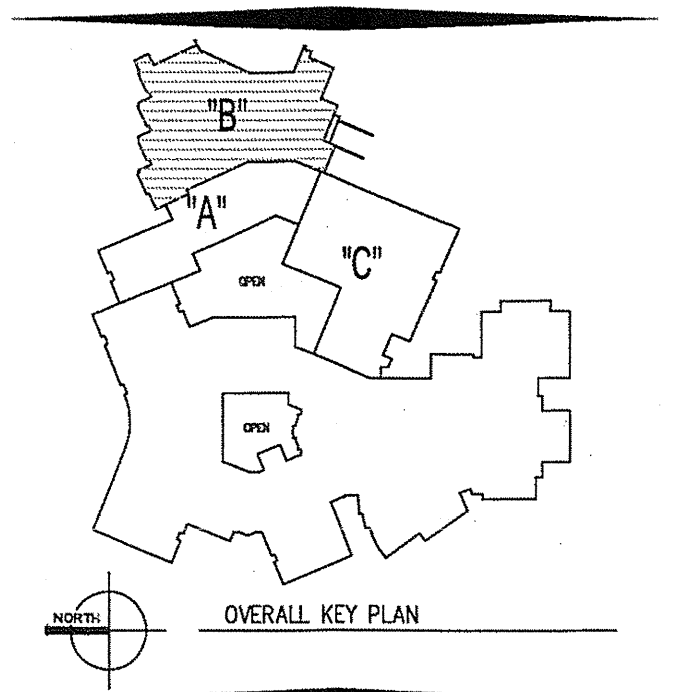

WAYLAND HIGH SCHOOL

HIGH SCHOOL ADDITIONS AND REMODELING

WAYLAND, MICHIGAN

Designed by: TGH, SS
 Drawn by: DWB
 Checked by: TGH, SS
 Date Drawn: 04-16-2009
 Sheet Title: ILS AUDITORIUM CONDUIT AND BOX LOCATIONS FLOOR PLAN

Sheet No. 9 of 16
 Drawing Scale: 1/8" = 1'-0"

AV220

DATE PLOTTED: Wednesday, June 24, 2009 1:27:25 PM