
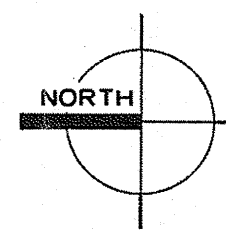


No part of this drawing may be reproduced in any form or by any means, stored in a database or retrieval system, without written permission of GBB Architects - Engineering.

9/5-1025/5-1025/1A/01
PLOT DATE / TIME: 6/25/2009 6:47:58 AM



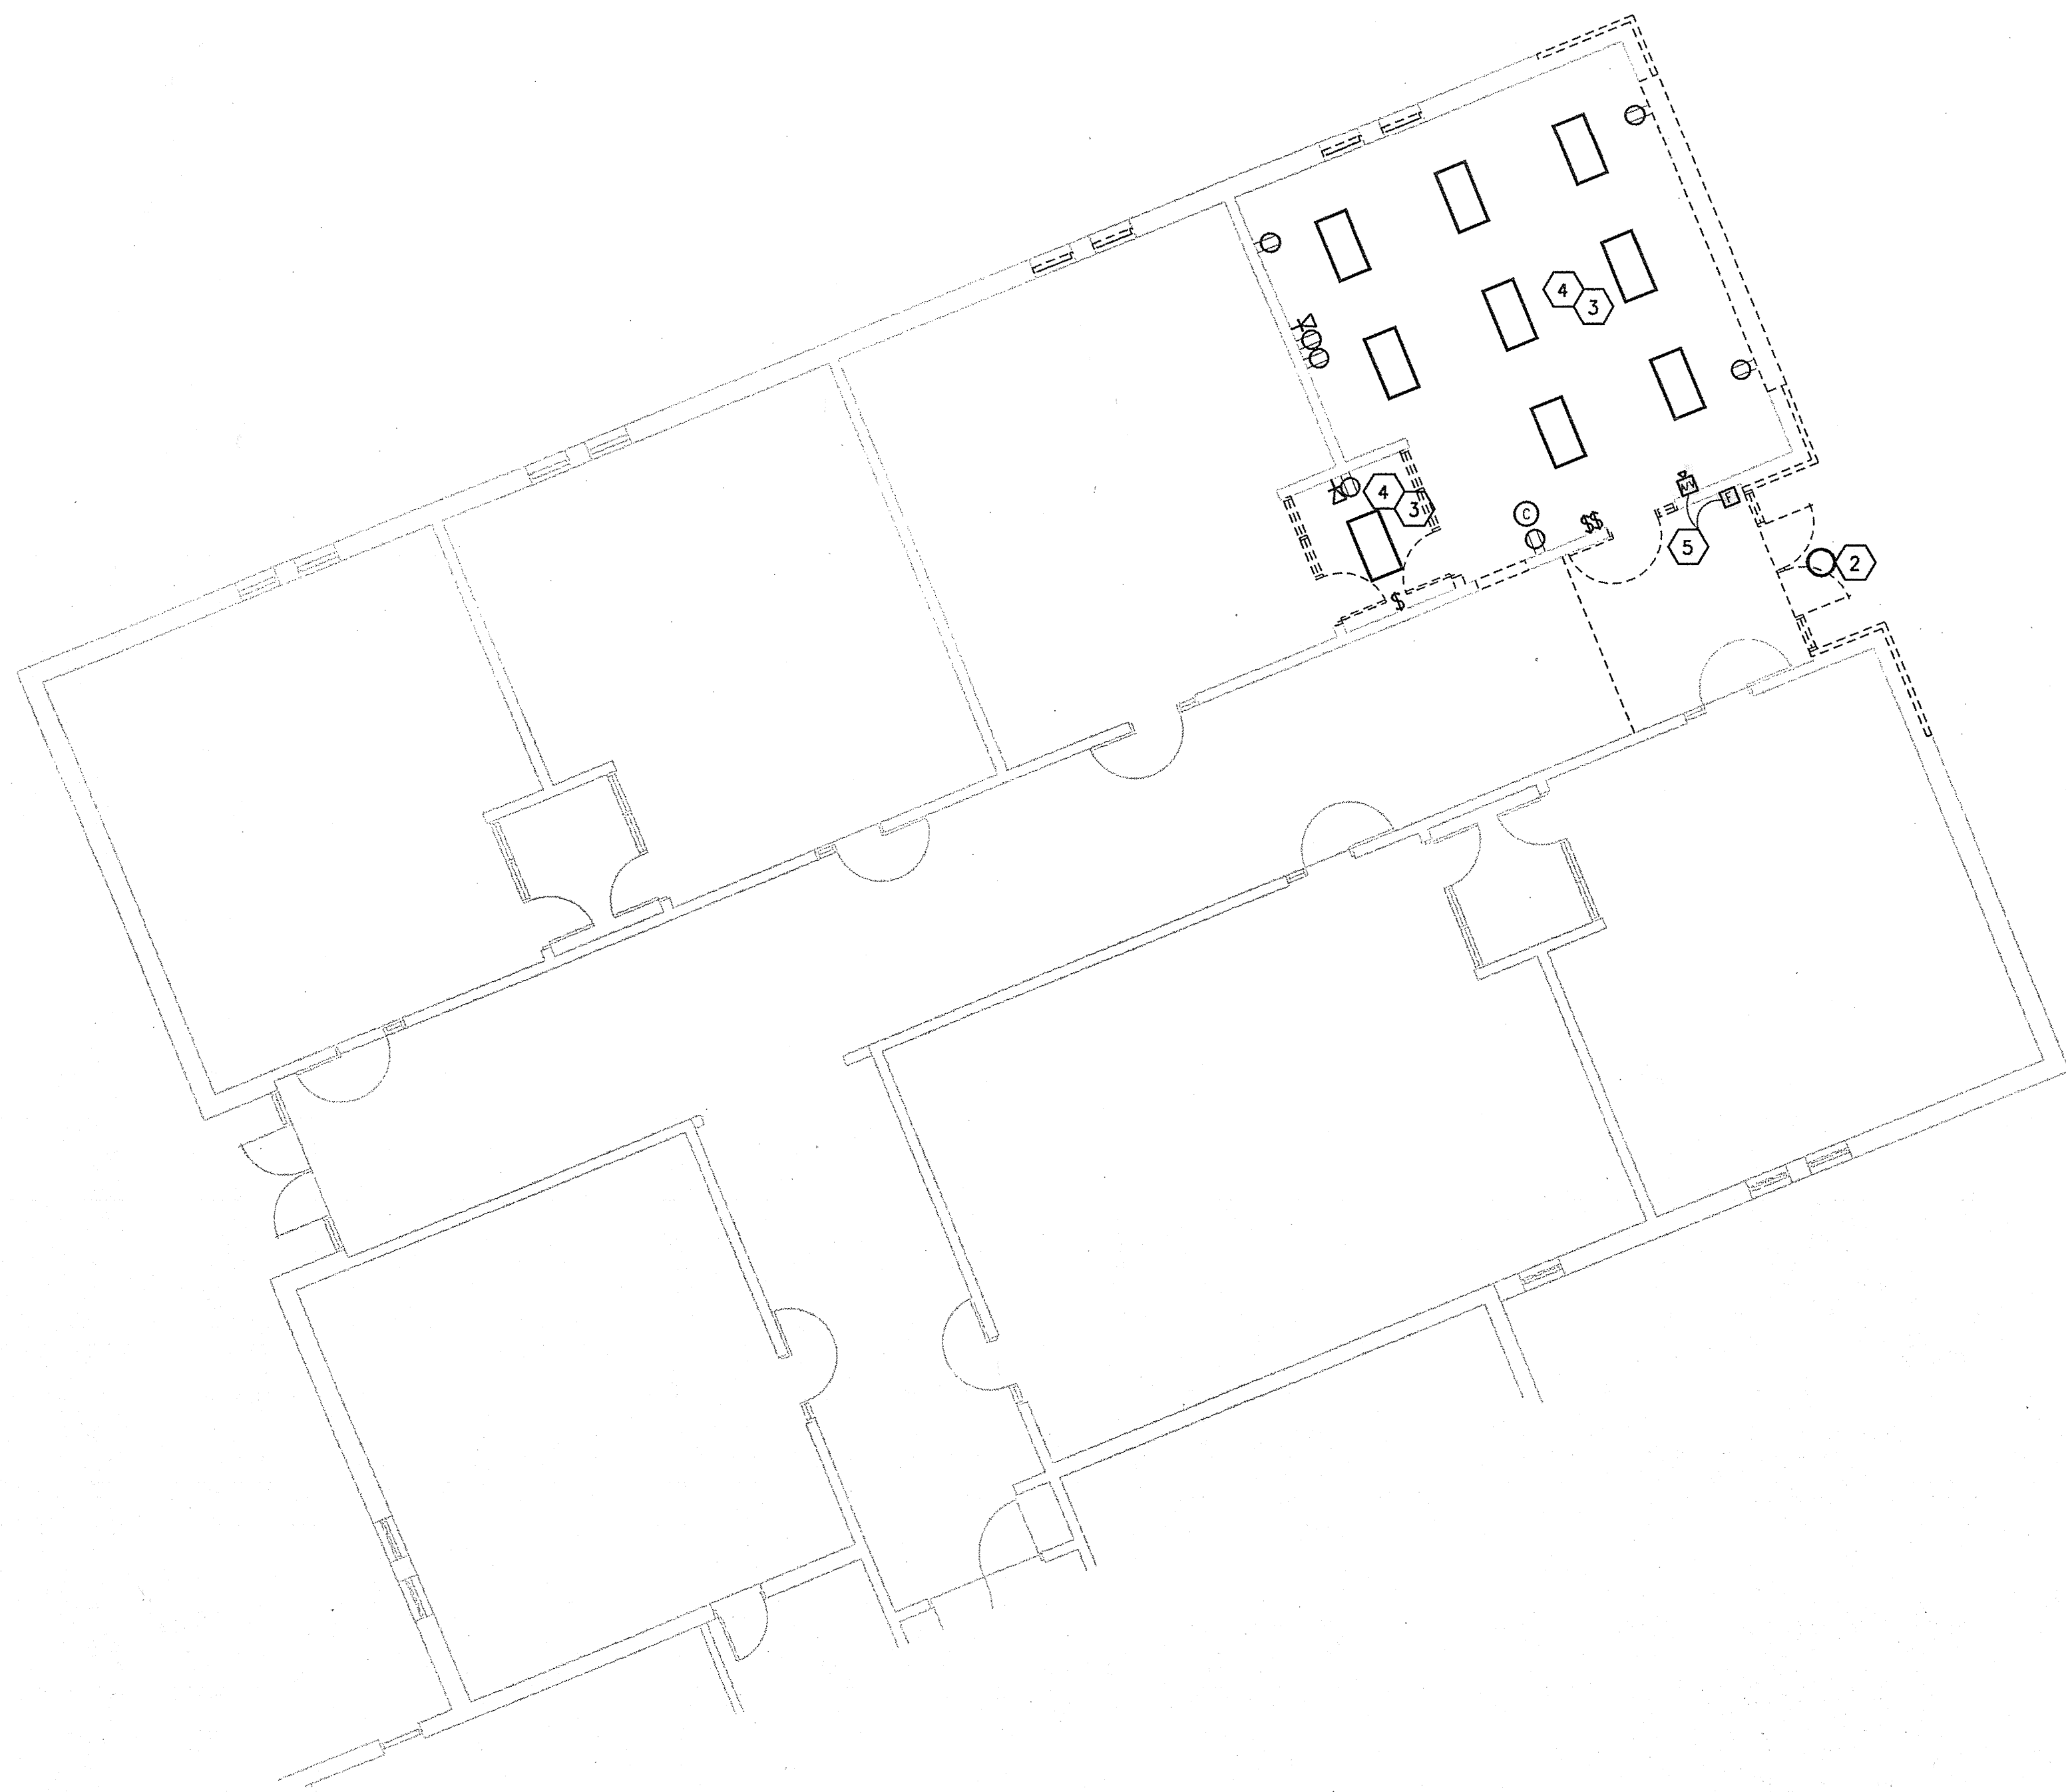


UNIT 'A' & 'C' FIRST FLOOR ELECTRICAL DEMOLITION PLAN

1/8" = 1'-0"

ELECTRICAL DEMOLITION KEY NOTES:

1. EXISTING DUST COLLECTION SYSTEM TO BE RELOCATED, INTERCEPT EXISTING CONDUIT AND EXTEND TO THE NEW LOCATION. PROVIDE NEW CONDUIT FROM EXISTING STARTER. PROVIDE NEW 480V 3-POLLE DISCONNECT.
2. EXISTING EXTERIOR LIGHTING, REMOVE LIGHTING, CONDUIT AND CONDUCTORS COMPLETE AS NEEDED. MAKE PROVISIONS TO BACK FEED EXISTING LIGHTING TO REMAIN THAT MAY BE FED THROUGH THE LIGHTING BEING REMOVED.
3. REMOVE EXISTING WIRING DEVICES SHOWN. REMOVE CONDUIT AND CONDUCTORS COMPLETE AS NEEDED. MAKE PROVISIONS TO BACK FEED EXISTING LIGHTING TO REMAIN THAT MAY BE FED THROUGH THE LIGHTING BEING REMOVED.
4. REMOVE EXISTING LIGHTING AND SWITCHING SHOWN. REMOVE CONDUIT AND CONDUCTORS COMPLETE.
5. REMOVE EXISTING FIRE ALARM DEVICE AND KEEP FROM DAMAGE. RETURN DEVICE TO OWNER.
6. CUT BACK V4000 WIREWAY OUT OF WAY OF NEW. ROLL UP FIRE DOOR THIS AREA. BACK FEED EXISTING RECEPTACLES ON EAST WALL TO REMAIN.

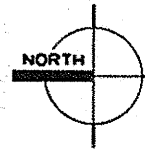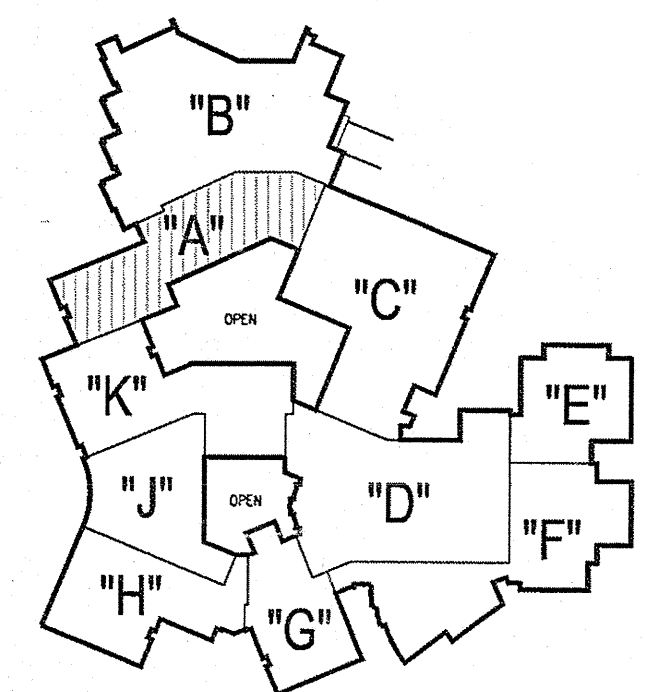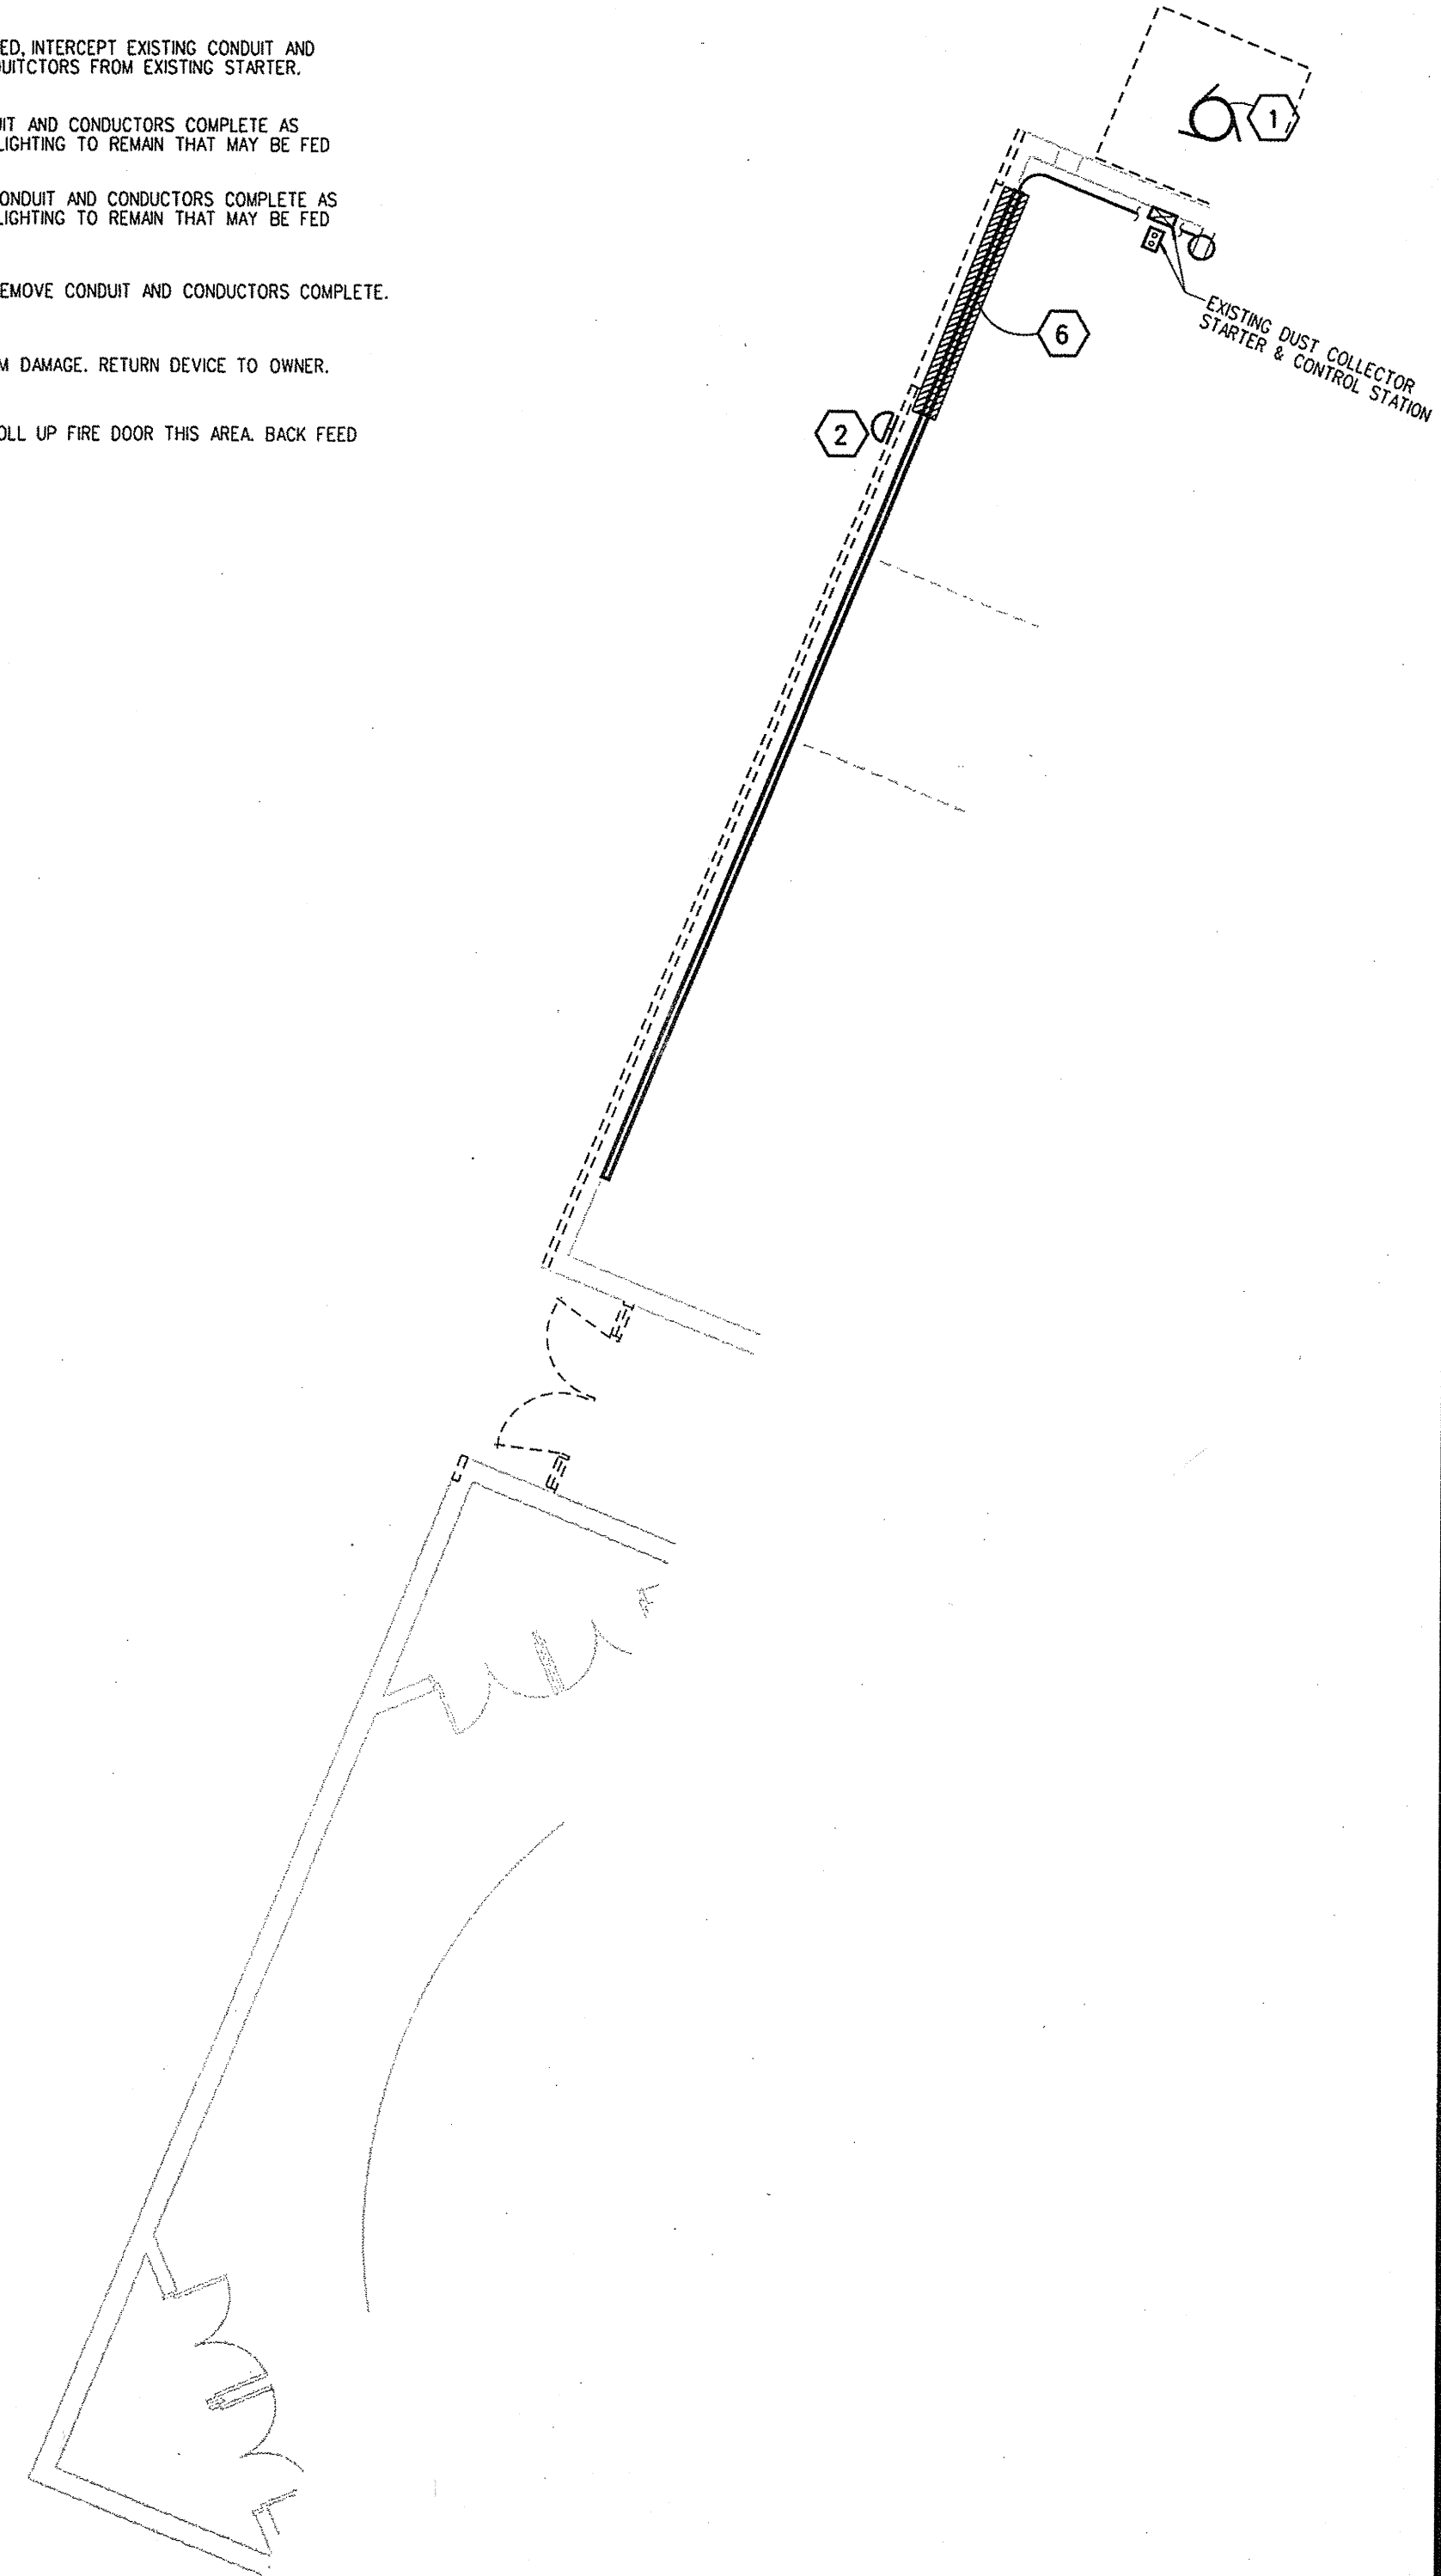

OVERALL KEY PLAN

FINE ARTS CENTER ADDITION
WAYLAND UNION SCHOOLS
WAYLAND, MICHIGAN

PROJECT NO. 5-1282
Copyright © 2009
GBB Architects - Engineering
All Rights Reserved

UNIT 'A' FIRST
FLOOR ELECTRICAL
DEMOLITION PLAN

E0.1A

