

NOTES:
1. FL-600P AND FL-710 AVAILABLE FROM ISR.
2. PWD-100 AVAILABLE FROM ISR.
3. ALL MOUNTING HEIGHTS ARE TO BOTTOM OF BOX.

NO SCALE

TERMS:
FURNISH = PROVIDE AND INSTALL.
PROVIDE = DELIVER TO CUSTOMER IN BOX.
INSTALL = TAKE PROVIDED PIECE AND INSTALL PER DRAWING AND SPEC.

1. ELECTRICAL CONTRACTOR SHALL FURNISH AND INSTALL ALL CONDUIT AND BOXES ASSOCIATED WITH THE AUDIO AND VIDEO SYSTEMS AS

1. ELECTRICAL CONTRACTOR SHALL PURCHASE AND INSTALL ALL CONDUIT AND BOXES ASSOCIATED WITH THE AUDIO AND VIDEO SYSTEMS AS SHOWN ON THE DRAWINGS.
2. ELECTRICAL CONTRACTOR SHALL SUPPLY ALL JUNCTION BOXES FOR THE AV SYSTEMS WITH APPROPRIATE COVERS.
3. ALL CONDUITS NOT SPECIFICALLY IDENTIFIED SHALL BE 3/4".
4. ALL CONDUITS BELOW GRADE SHALL BE PVC OR AS REQUIRED BY CODE. ALL CONDUITS ABOVE GRADE SHALL BE EMT OR AS REQUIRED BY CODE.
5. NO CONDUIT SHALL BE INSTALLED WITH MORE THAN THREE (3) BENDS (DOGS). IF A CONDUIT RUN REQUIRES MORE THAN THREE (3) BENDS IF THE CONDUIT RUN IS IN EXCESS OF 150' IN TOTAL LENGTH, INSERT A 45 DEGREE ELBOW. IF THE RUN TOTAL LARGE SIZE CONDUIT.
6. ALL CONDUITS TO BE LABELED AT THE DISTRIBUTION BOX WITH THE IDENTIFICATION BOX IN A CLEAR AND LOGICAL MANNER.
7. ENDS OF ALL CONDUITS ARE TO BE DEBURRED AND NOTED BUSHING.
8. ELECTRICAL CONTRACTOR SHALL SUPPLY A RACK RAIL IN EACH CONDUIT.
9. ALL LINE VOLTAGE WIRE FOR THE SOUND AND VIDEO SYSTEMS SHALL BE SUPPLIED AND INSTALLED BY THE ELECTRICAL CONTRACTOR.
10. LINE VOLTAGE CONDUITS SHALL MAINTAIN A MINIMUM OF 3" SEPARATION FROM AUDIO SIGNAL CONDUITS UNLESS TO CROSS AT 90° WHEN NECESSARY.
11. FLOOR PROTECT SHALL BE SUPPLIED AND INSTALLED BY THE ELECTRICAL CONTRACTOR.
12. FISH HOLES & 6" TECHNICAL GROUND WIRE FROM THE INSULATED GROUND BUS BARS IN THE TECHNICAL POWER LOAD PANEL TO THE MAIN AUDIO EQUIPMENT RACK.
13. TECHNICAL POWER OUTLETS SHALL BE ISOLATED GROUND RECEPTACLES. SEE ELECTRICAL SPECIFICATION FOR CODES AND PART NUMBERS.

F. ALL LOW VOLTAGE WIRE FOR THE SOUND AND VIDEO SYSTEMS SHALL BE SUPPLIED AND INSTALLED BY THE AV CONTRACTOR

2. NO WIRE SPICES IN CONDUIT.
3. REFER TO SPECIFICATIONS FOR ADDITIONAL INSTALLATION DETAILS.
4. ENGRAVED PANELS IN FLOOR BOXES AND ON WALL PLATES SHALL BE FURNISHED AND INSTALLED BY THE AV CONTRACTOR.




2 — NO SCALE

NOTES:
1. NOT ALL WIRE TYPES NECESSARILY USED.
2. ALL LOW VOLTAGE WIRE FOR THE AV SYSTEMS TO BE SUPPLIED
AND INSTALLED BY THE AV CONTRACTOR.


3 — NO SCALE

----- FREE-WIRED BY AV CONTRACTOR
 _____ CONDUIT BY ELECTRICAL CONTRACTOR

4 NO SCALE

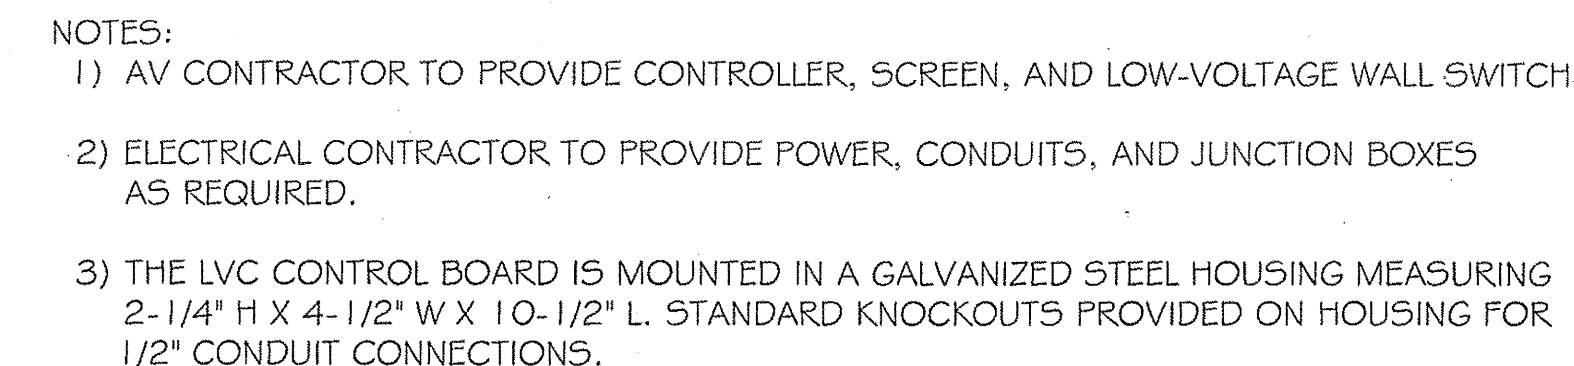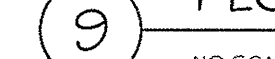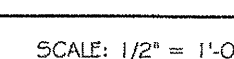

(10) — NO SCALE

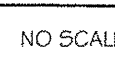[illegible]

8 NO SCALE