
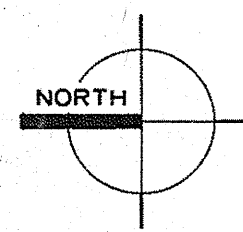


No part of this drawing may be reproduced in any form or by any means, stored in a database or retrieval system, without written permission of CMB Architecture + Engineering.


PLS: 05/25/2009 6:48:30 AM
PLOT DATE / TIME: 6/25/2009 6:48:30 AM

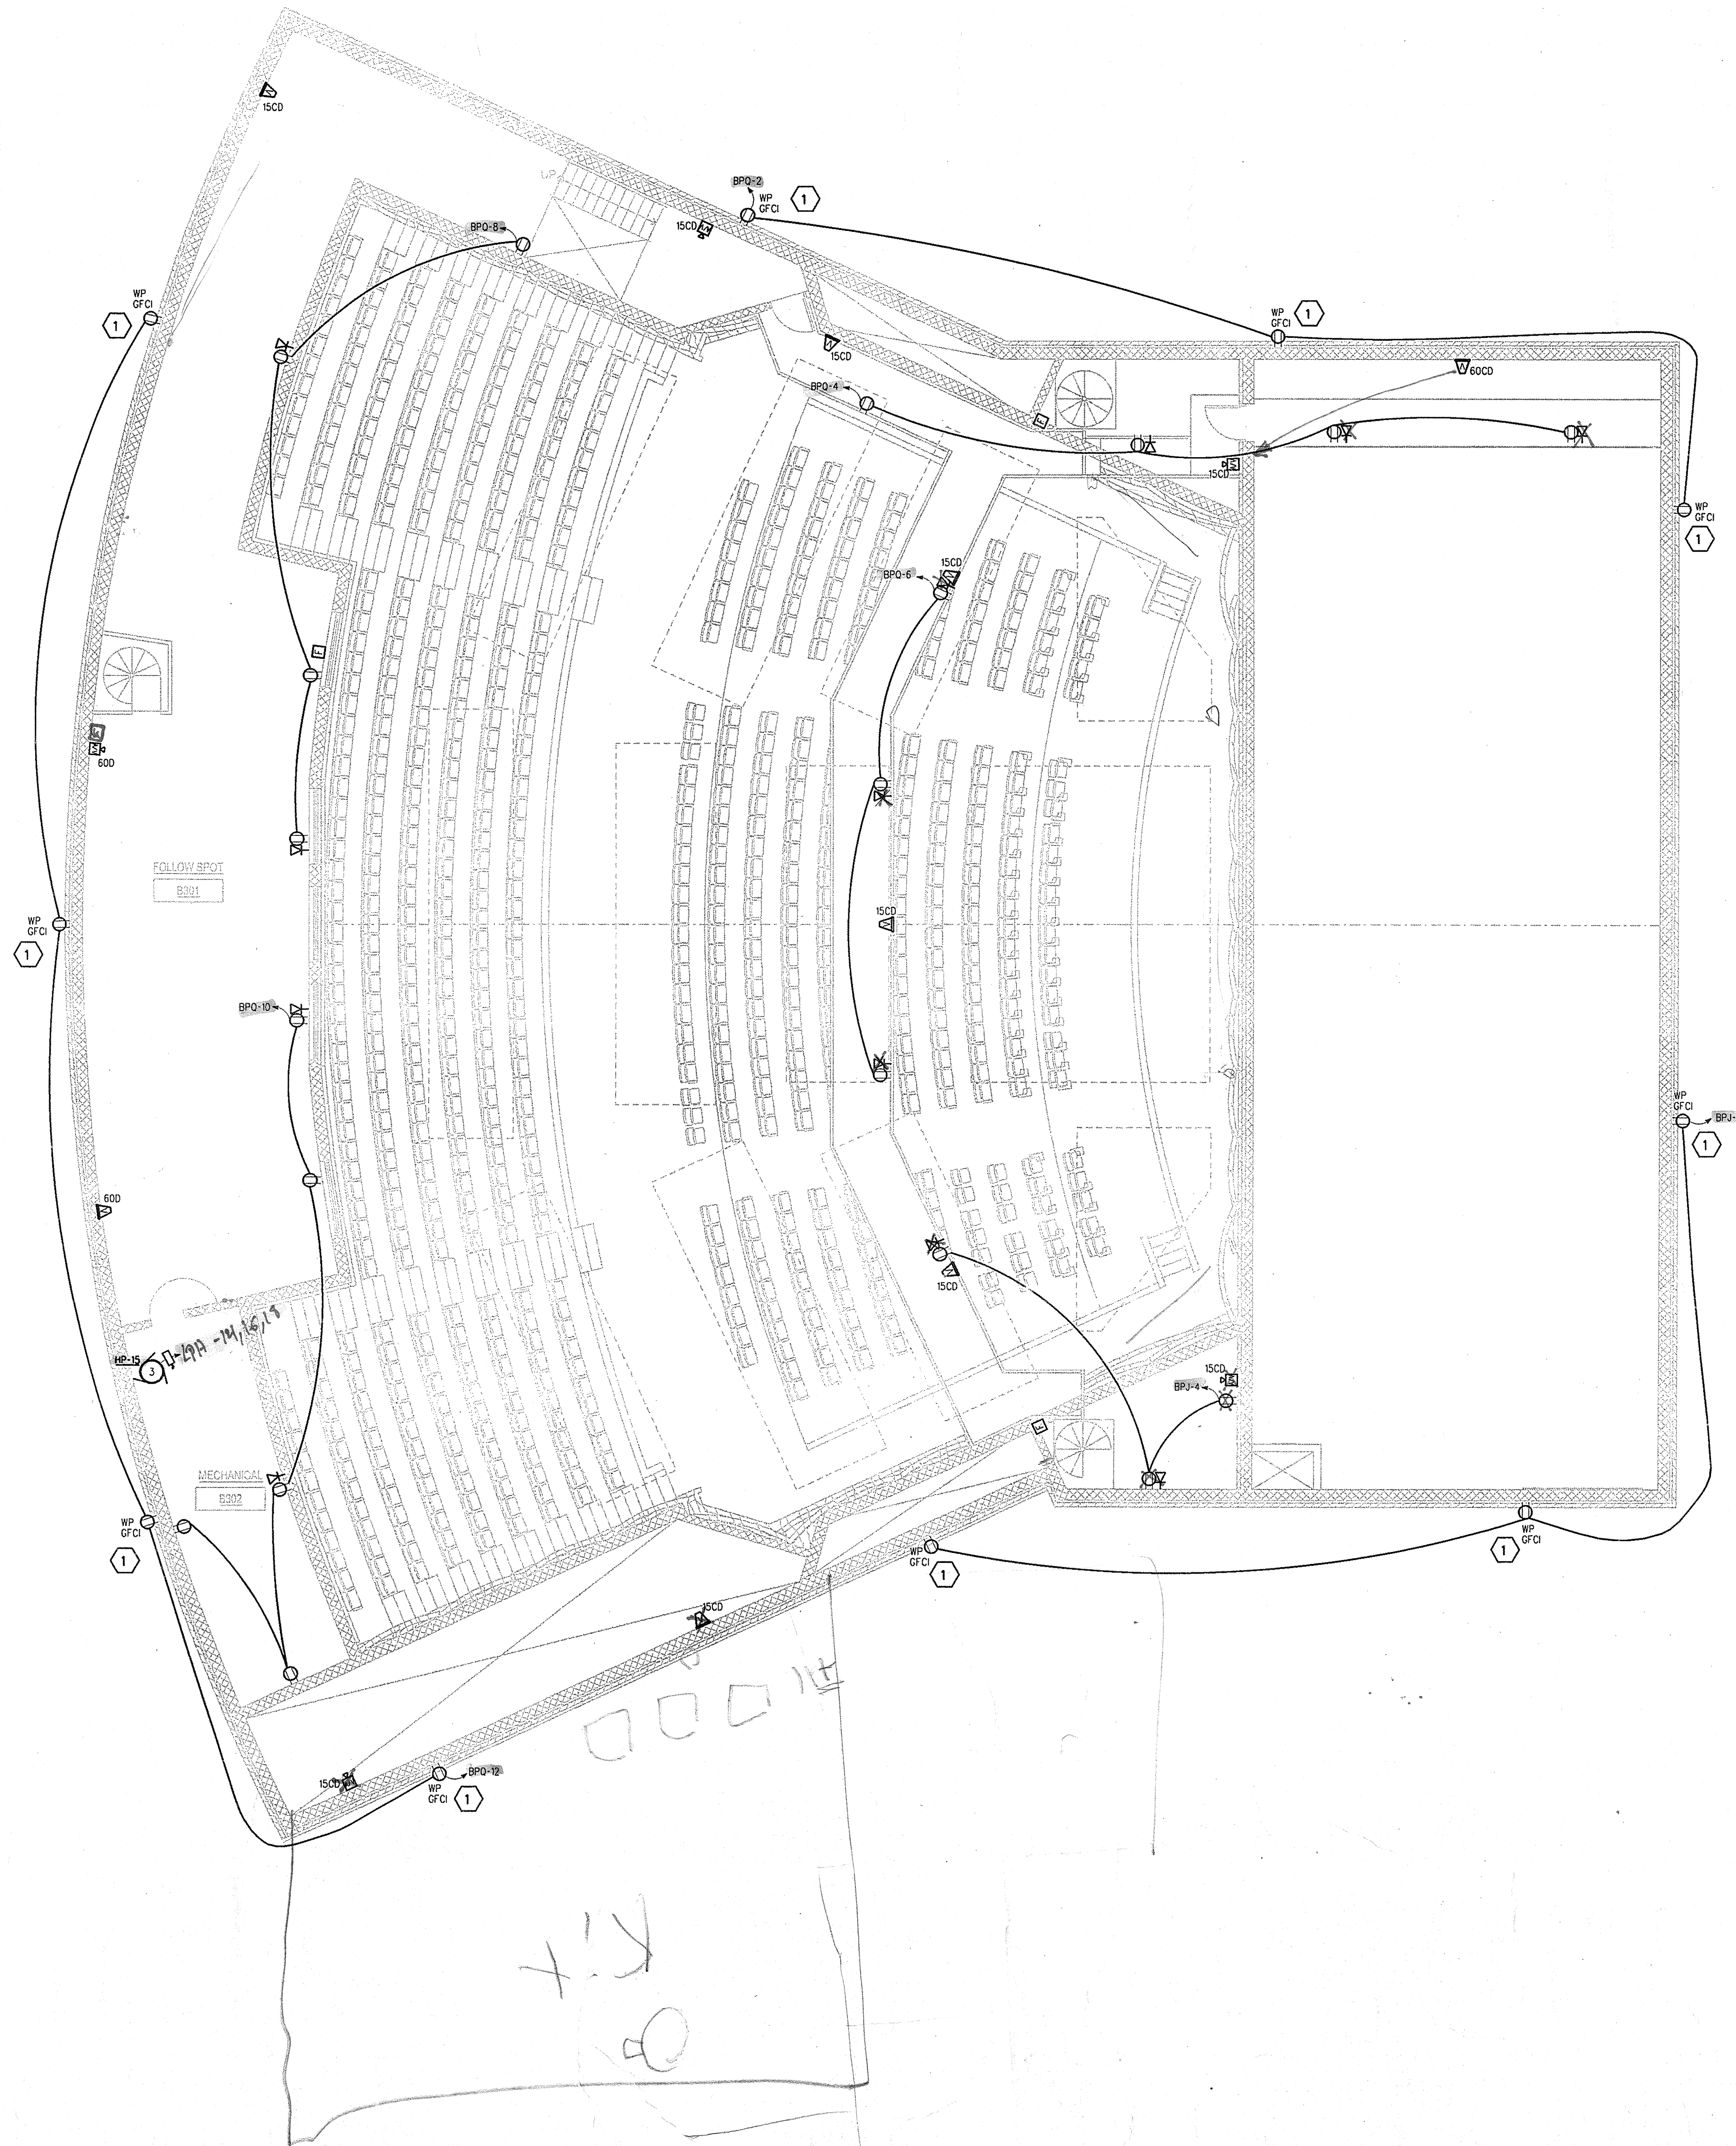

UNIT 'B' CATWALK POWER PLAN
1/8" = 1'-0"

ELECTRICAL KEY NOTES:

- 1 MOUNT RECEPTACLE ON WALL ABOVE ROOF AT 18" ABOVE ROOF.

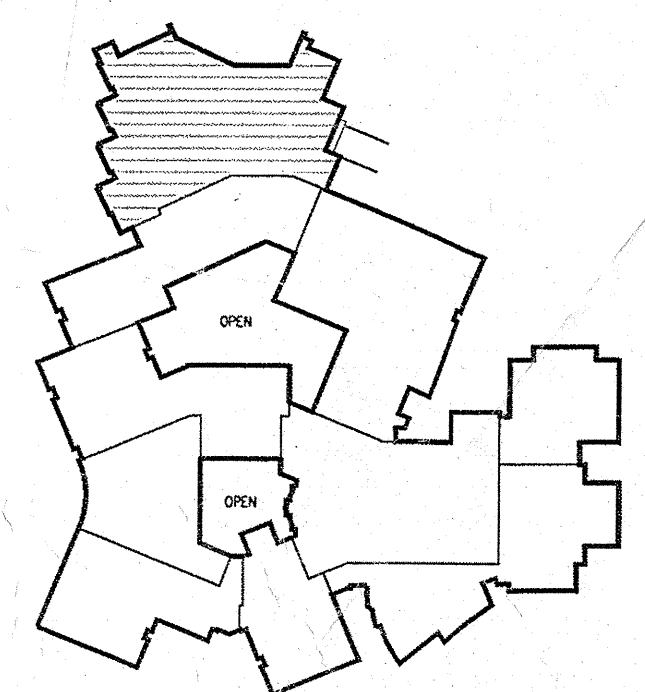

OVERALL KEY PLAN

FINE ARTS CENTER ADDITION
WAYLAND UNION SCHOOLS
WAYLAND, MICHIGAN

PROJECT NO. 5-1282
Copyright © 2009
CMB Architecture + Engineering
All Rights Reserved

UNIT 'B'
CATWALK
POWER PLAN

E2.3B



DATE	BY	REVISIONS