




3 AV EQUIPMENT ELEVATION
SCALE: 1/8" = 1'

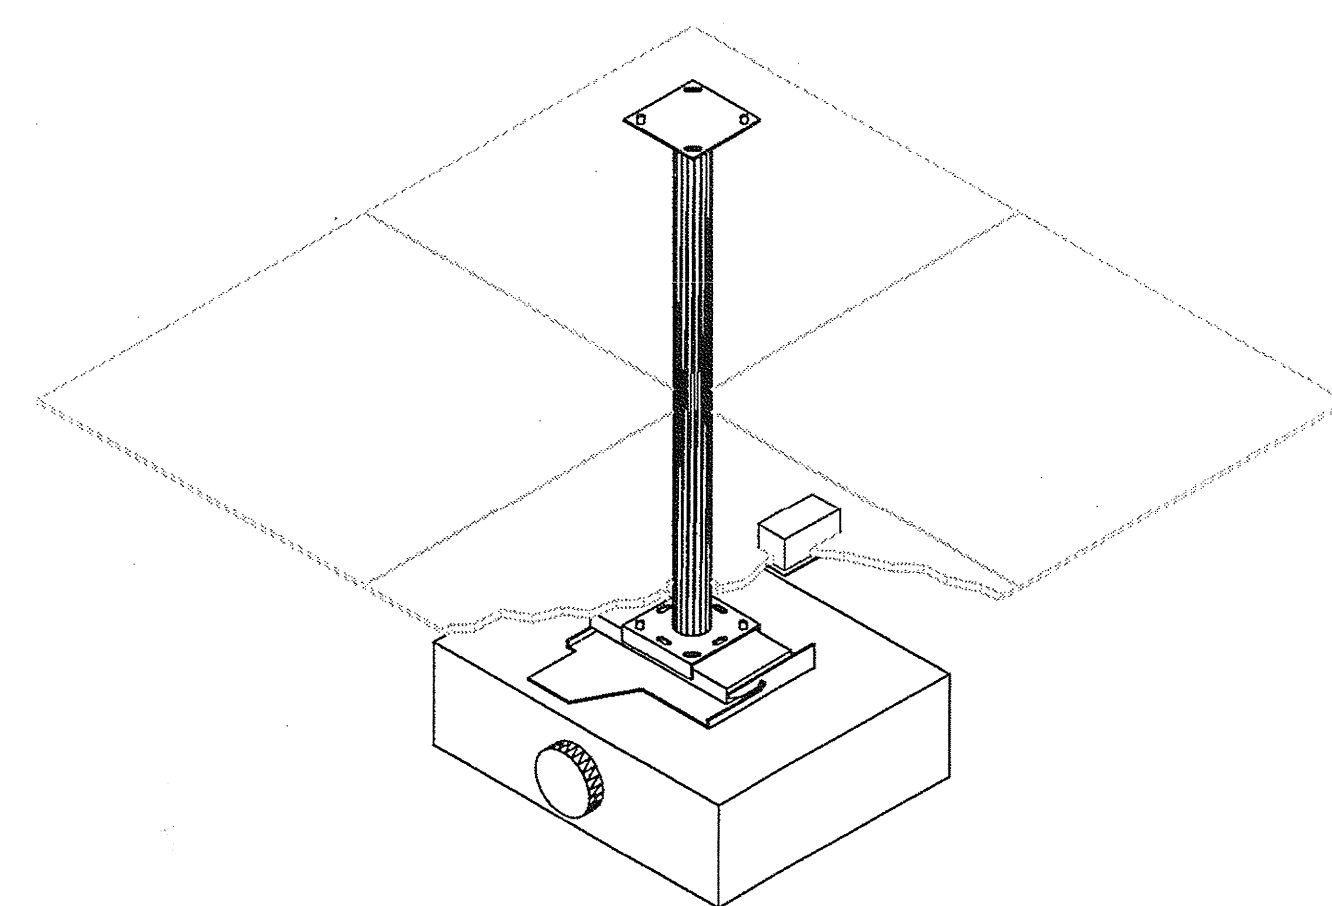


4 BOOTH PROJECTOR INSTALLATION CONCEPT
NO SCALE

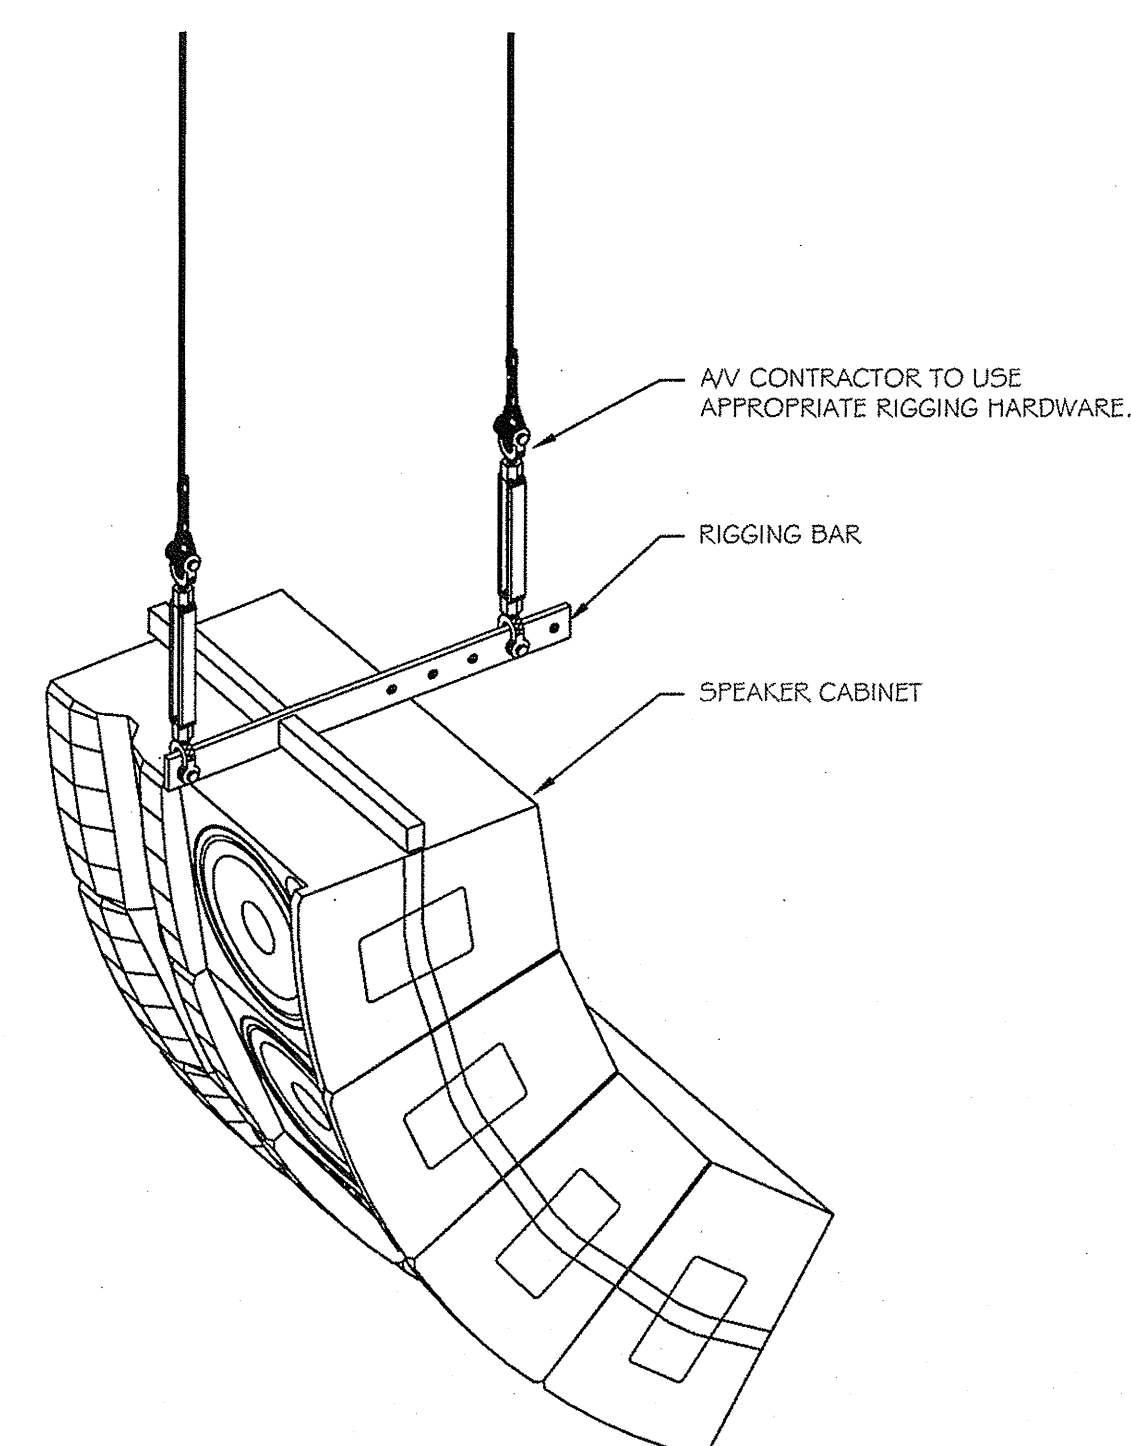

5 SPEAKER RIGGING DETAIL
NO SCALE

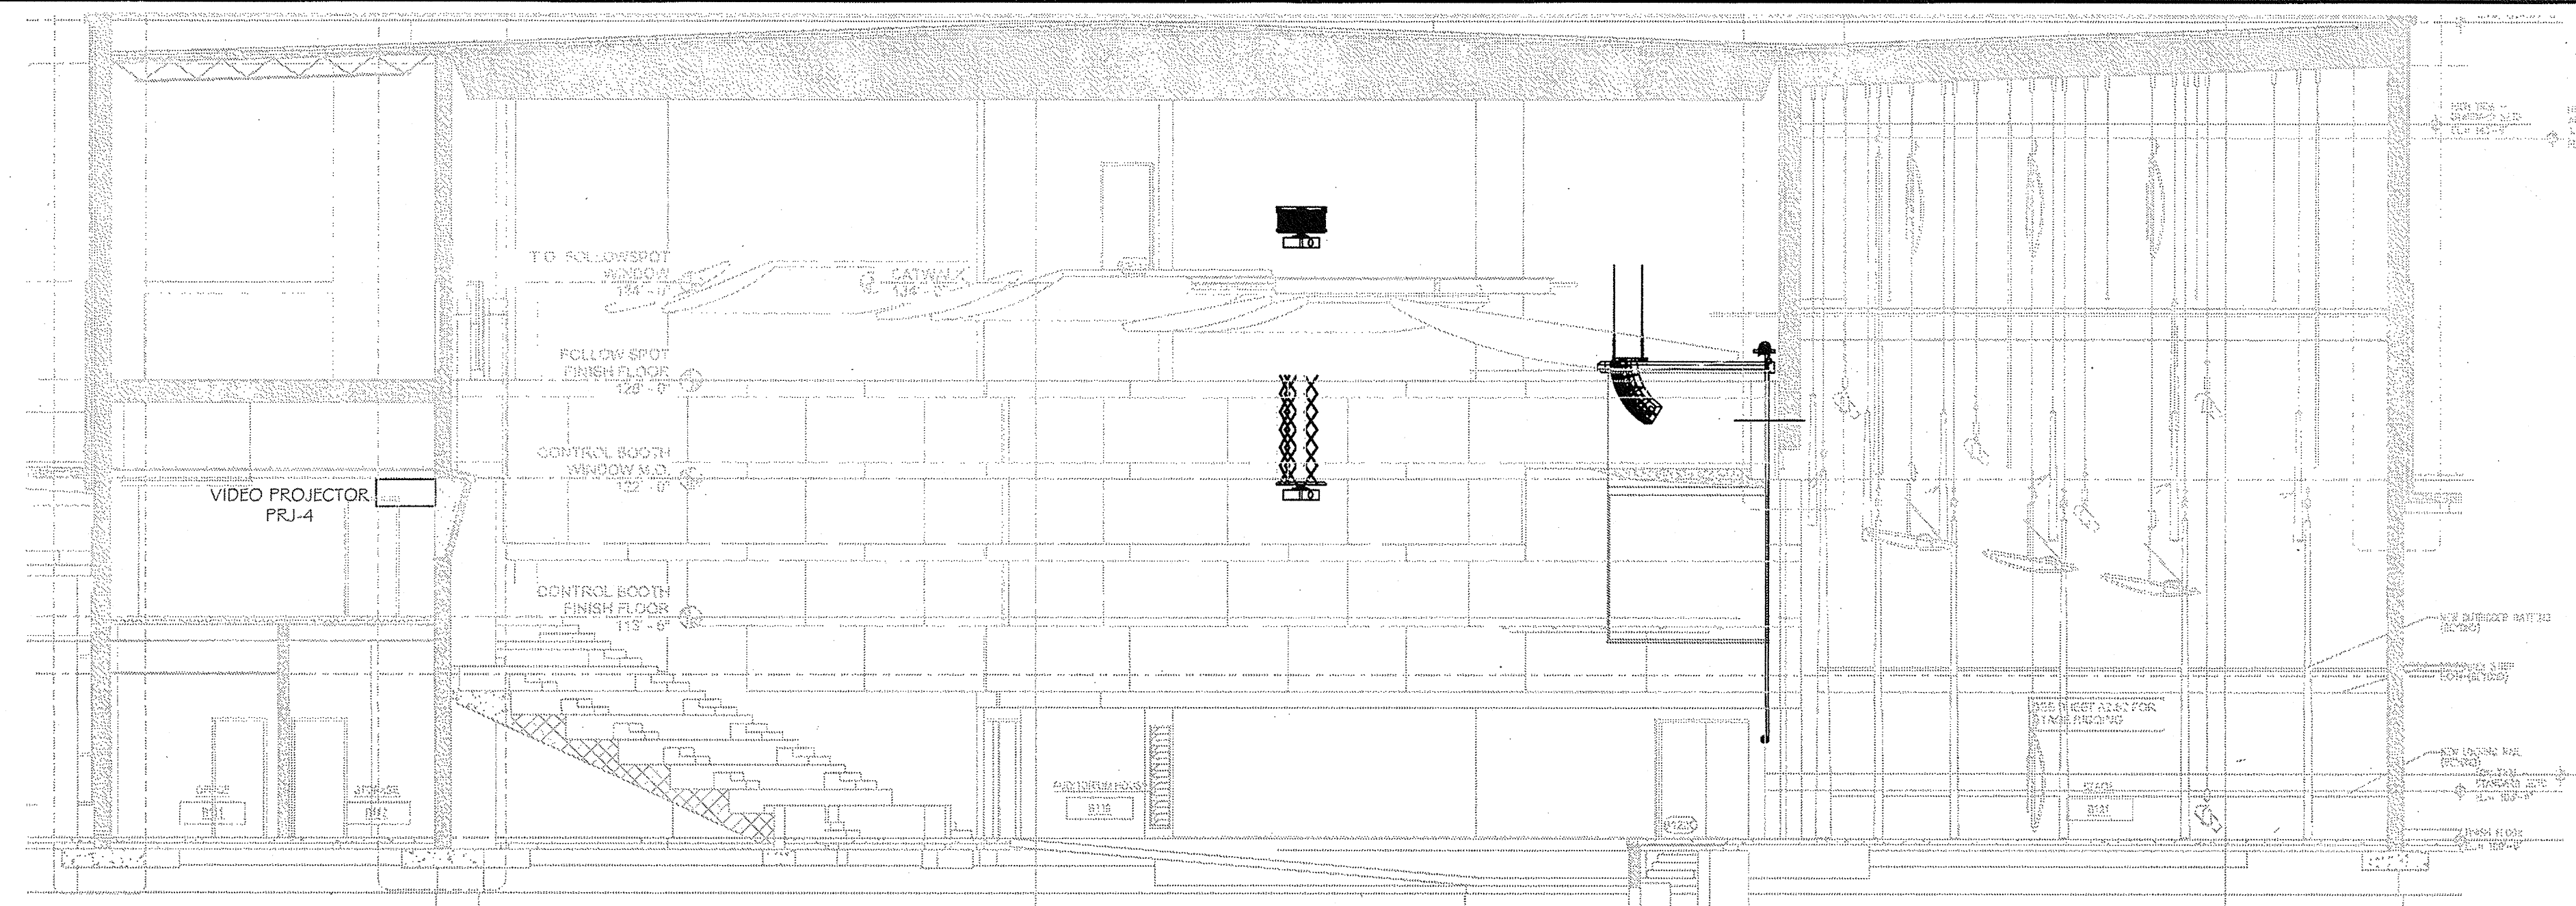

2 AV EQUIPMENT SECTION
SCALE: 1/8" = 1'

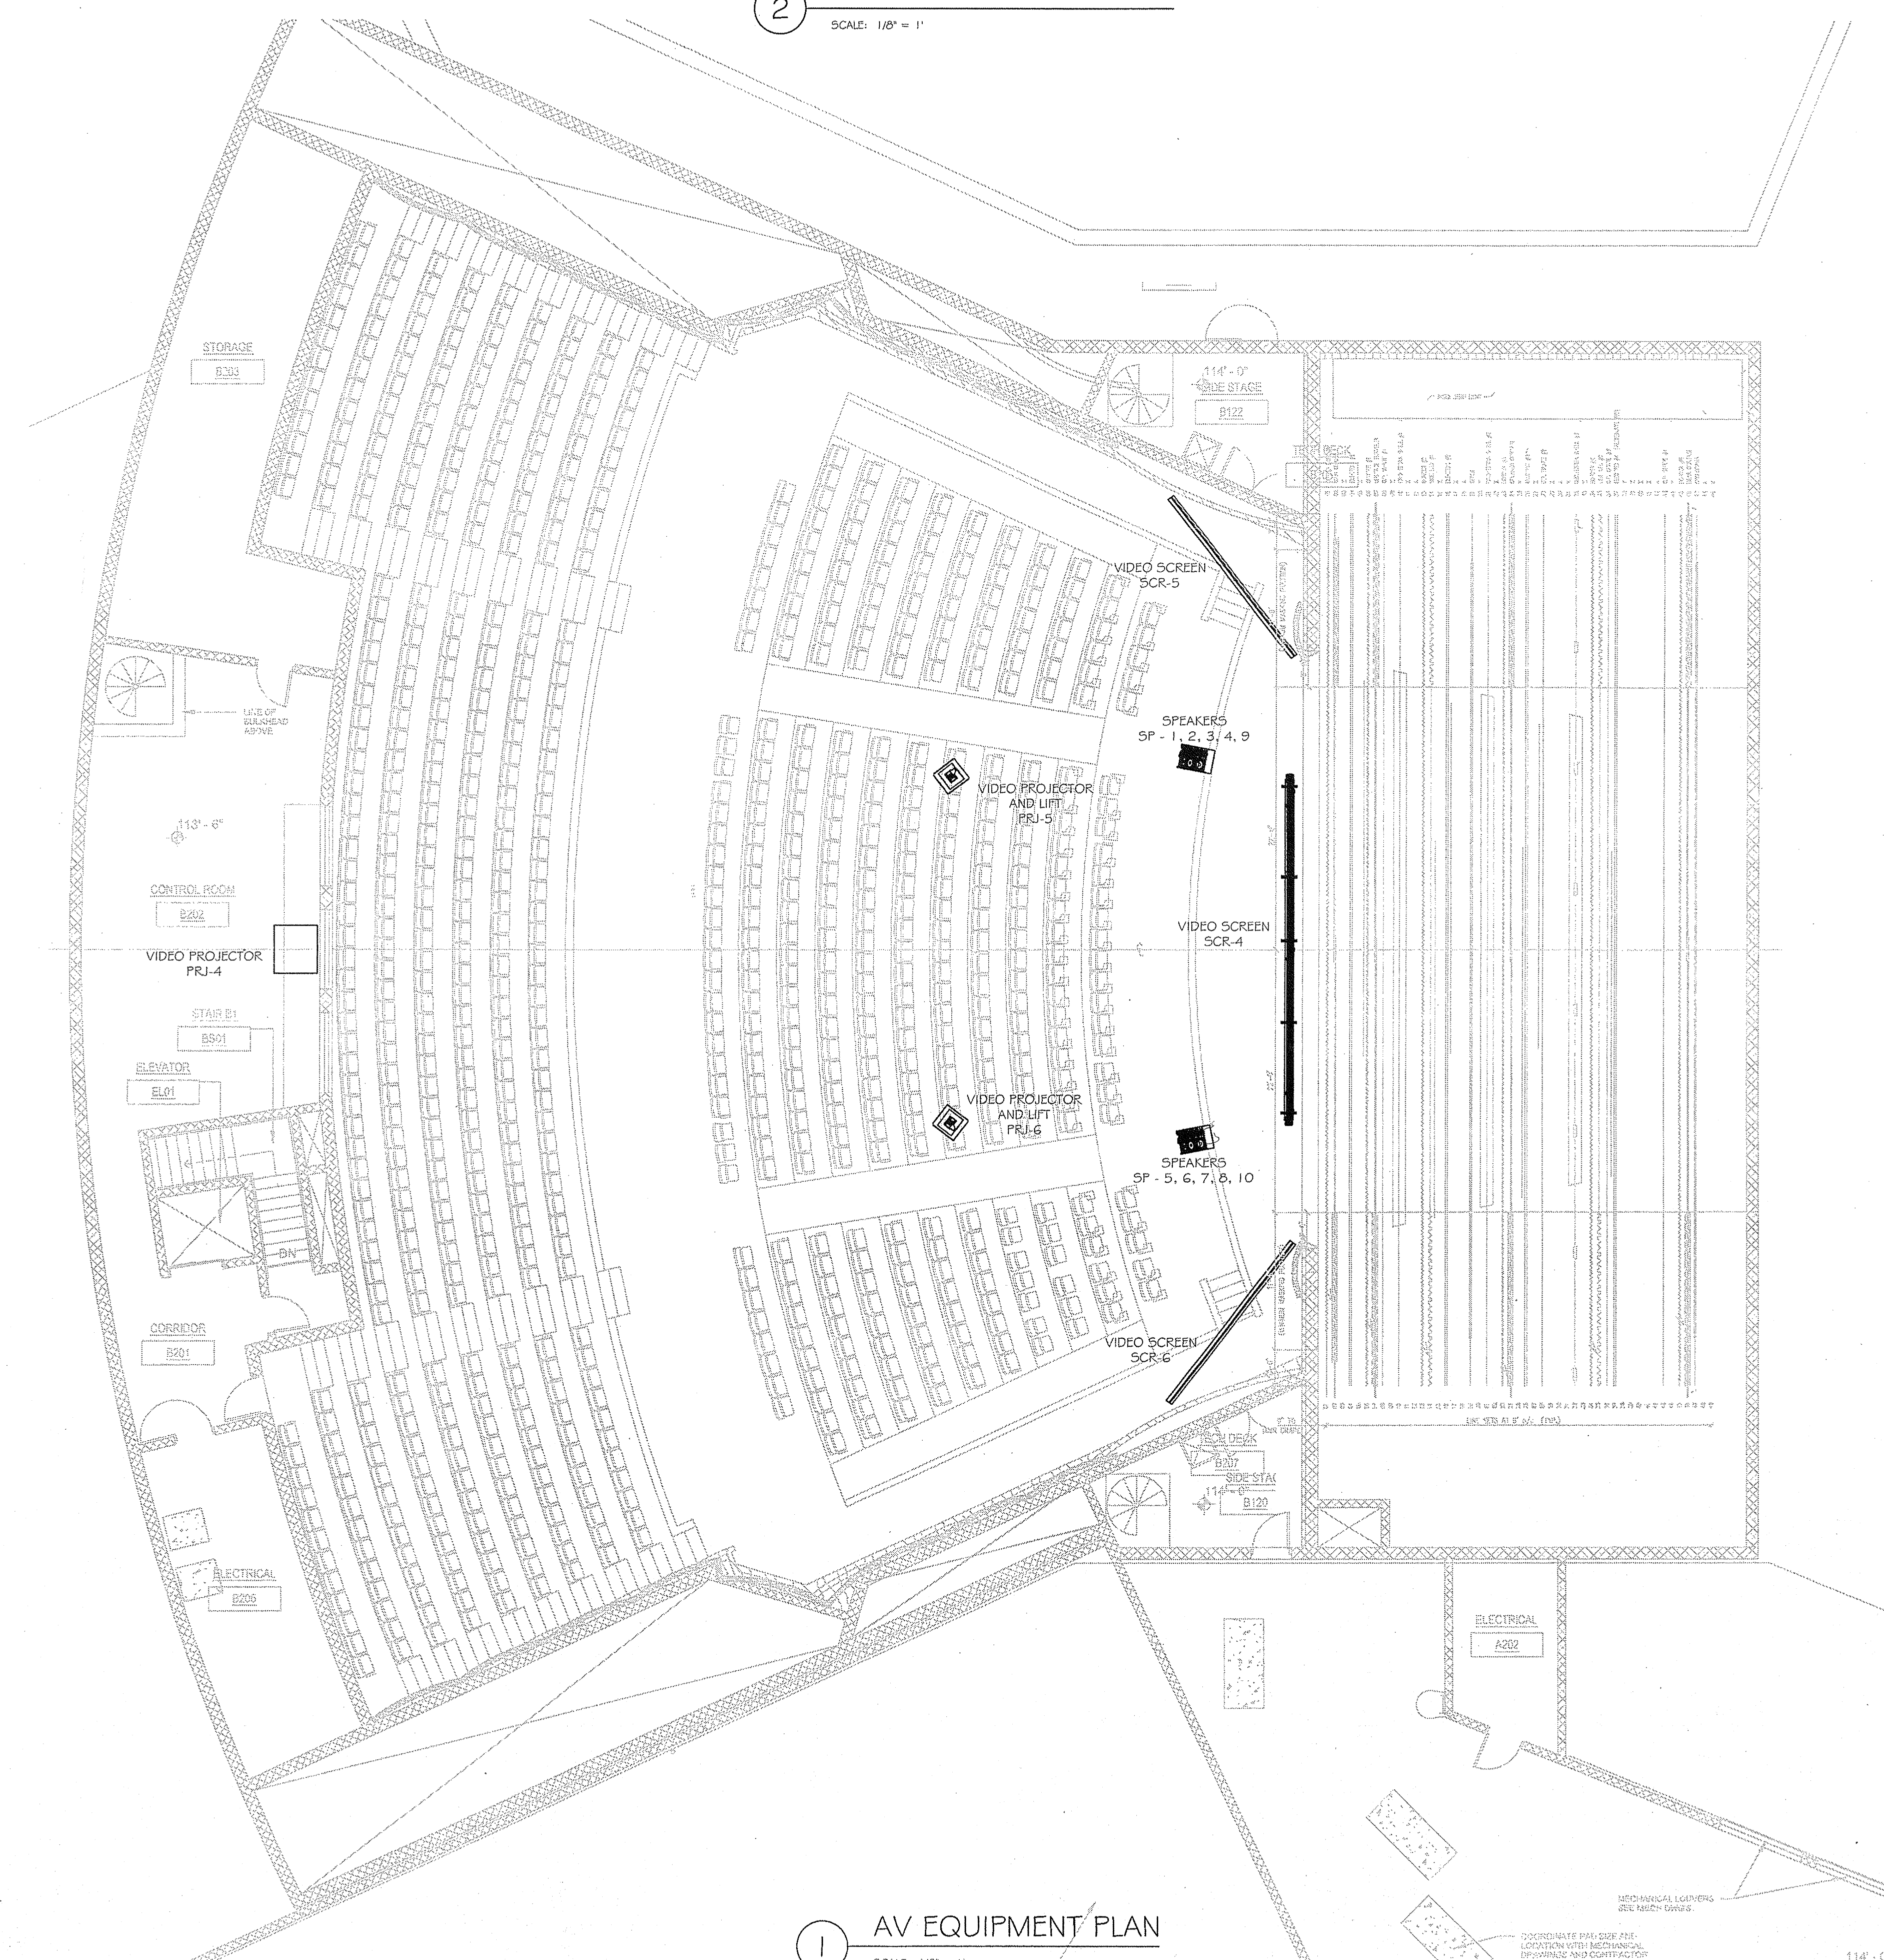

1 AV EQUIPMENT PLAN
SCALE: 1/8" = 1'

DATES OF ISSUE		
NO.	DATE	DESCRIPTION
1	5-7-09	GC REVIEW
2	6-24-09	BIDS AND CONSTRUCTION
3		
4		
5		
6		
7		
8		
9		
10		
11		
12		

Copyright 2009 Acoustics By Design, Inc. All information on this drawing is the exclusive property of Acoustics By Design, Inc. and is furnished for use on the above project only. No part of this drawing may be duplicated without written consent from Acoustics By Design, Inc.

WAYLAND HIGH SCHOOL

HIGH SCHOOL ADDITIONS AND REMODELING

WAYLAND, MICHIGAN

Designed by: TGH, SS
Drawn by: DWB
Checked by: TGH, SS
Sheet Title: AUDIO / VIDEO EQUIPMENT LOCATIONS AND DETAILS

Sheet No. 10 of 16
Drawing Scale: NONE

AV301