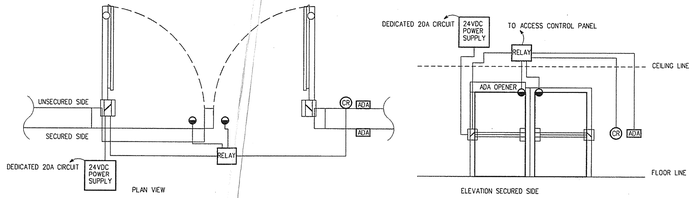

3 E5.01 DOUBLE DOOR, DOOR CONTACT, CARD READER, ADA OPERATOR, ELECTIC LATCH RETRACTION, BUILT-IN REQUEST TO EXIT
SCALE: NONE

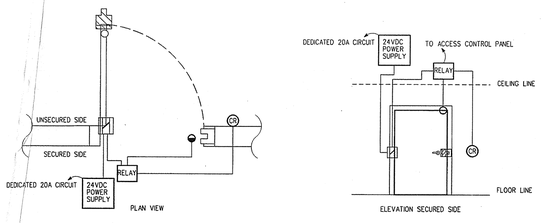

3 E5.01 SINGLE DOOR, DOOR CONTACT, CARD READER, ELECTRIC LATCH RETRACTION, BUILT-IN REQUEST TO EXIT
SCALE: NONE

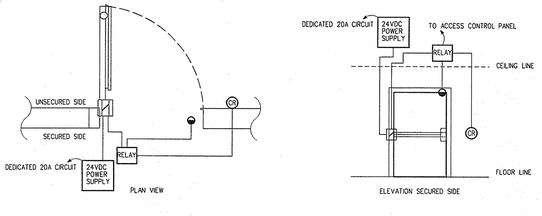

3 E5.01 SINGLE DOOR, DOOR CONTACT, CARD READER, ELECTIC LATCH RETRACTION, BUILT-IN REQUEST TO EXIT
SCALE: NONE

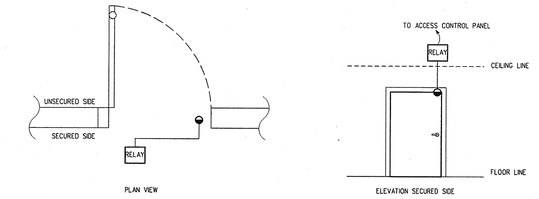

3 E5.01 SINGLE DOOR, DOOR CONTACT ONLY
SCALE: NONE

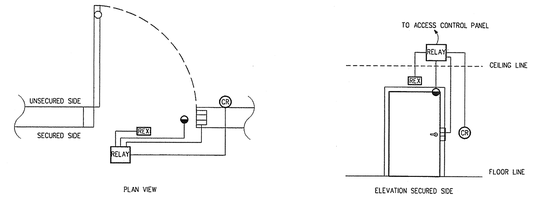

3 E5.01 SINGLE DOOR, DOOR CONTACT, CARD READER, ELECTRIC STRIKE, PIR REQUEST TO EXIT
SCALE: NONE

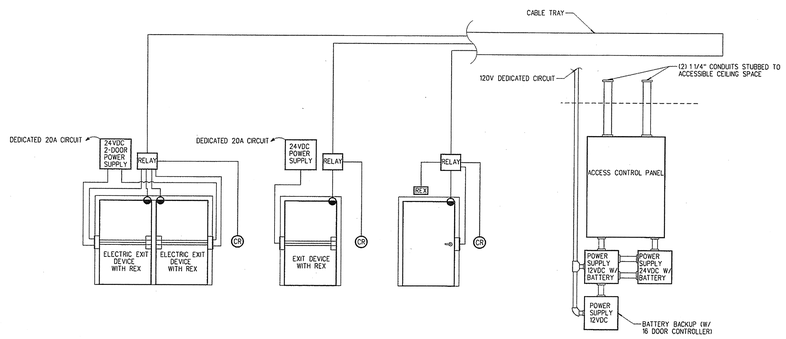

3 E5.01 TYPICAL ACCESS CONTROL PANEL LAYOUT
SCALE: NONE

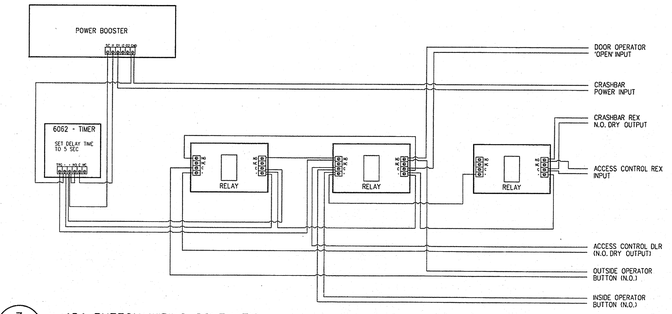

3 E5.01 ADA BUTTON WIRING SCHEMATIC
SCALE: NONE

GMB Architects - Engineers
85 East Eighth Street, Suite 200
Holland, MI 49423

REVISIONS

ISSUANCES

DRAWN BY: NCC

FINE ARTS CENTER ADDITION
WAYLAND UNION SCHOOLS
WAYLAND, MICHIGAN

PROJECT NO. 5-1282

Copyright © 2009
GMB Architects + Engineers
All Rights Reserved

ACCESS CONTROL DETAILS

E7.02

No part of this drawing may be reproduced in any form or by any means, stored in a database or retrieval system, without written permission of GMB Architecture + Engineering

g:\5-1282\5-1282E703.dgn scollg
PLOT DATE / TIME: 6/25/2009 6:49:05 AM